


1 LOCATION OF WATER WELL: County: Stevens Fraction: SE 1/4 NE 1/4 NW 1/4 Section Number: 6 Township Number: T 34 S Range Number: R 37 E/W

Distance and direction from nearest town or city street address of well if located within city?
2 miles west and 3 south of Hugoton, Ks.

2 WATER WELL OWNER: Pelajo Properties
 RR#, St. Address, Box #: % M. A. Owens Board of Agriculture, Division of Water Resources
 City, State, ZIP Code: 6104 Copperhill Dr., Dallas, TX 75248 Application Number:

3 LOCATE WELL'S LOCATION WITH AN "X" IN SECTION BOX:

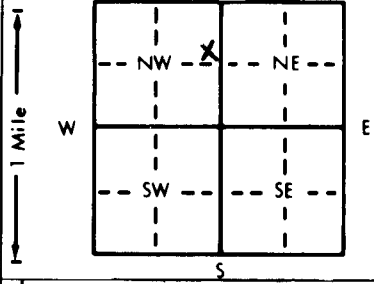

4 DEPTH OF COMPLETED WELL: 58.5 ft. ELEVATION: slope
 Depth(s) Groundwater Encountered: 1.154 ft. 2. ft. 3. ft.
 WELL'S STATIC WATER LEVEL: 15.4 ft. below land surface measured on mo/day/yr 4/14/98
 Pump test data: Well water was ft. after hours pumping gpm
 Est. Yield: 2000 gpm: Well water was ft. after hours pumping gpm
 Bore Hole Diameter: 2.4 in. to 58.5 ft. and in. to ft.
 WELL WATER TO BE USED AS:
 1 Domestic 3 Feedlot 6 Oil field water supply 8 Air conditioning 11 Injection well
 2 Irrigation 4 Industrial 7 Lawn and garden only 9 Dewatering 12 Other (Specify below)
 Was a chemical/bacteriological sample submitted to Department? Yes No If yes, mo/day/yr sample was submitted
 Water Well Disinfected? Yes No

5 TYPE OF BLANK CASING USED:
 1 Steel 2 PVC 3 RMP (SR) 4 ABS 5 Wrought iron 6 Asbestos-Cement 7 Fiberglass 8 Concrete tile 9 Other (specify below)
 CASING JOINTS: Glued Clamped Welded Threaded
 Blank casing diameter: 1.6 in. to 2.50 ft. Dia. 1.6 in. to 4.65 ft. Dia. in. to ft.
 Casing height above land surface: 2.0 in., weight 36.91 lbs./ft. Wall thickness or gauge No. 219
 TYPE OF SCREEN OR PERFORATION MATERIAL:
 1 Steel 2 Brass 3 Stainless steel 4 Galvanized steel 5 Fiberglass 6 Concrete tile 7 PVC 8 RMP (SR) 9 ABS 10 Asbestos-cement 11 Other (specify) 12 None used (open hole)
 SCREEN OR PERFORATION OPENINGS ARE:
 1 Continuous slot 2 Mill slot 3 Louvered shutter 4 Key punched 5 Gauzed wrapped 6 Wire wrapped 7 Torch cut 8 Saw cut 9 Drilled holes 10 Other (specify) 11 None (open hole)
 SCREEN-PERFORATED INTERVALS: From 2.50 ft. to 2.90 ft. From 4.65 ft. to 5.85 ft.
 GRAVEL PACK INTERVALS: From 2.0 ft. to 5.85 ft.

6 GROUT MATERIAL: 1 Neat cement 2 Cement grout 3 Bentonite 4 Other
 Grout Intervals: From 0 ft. to 2.0 ft. From ft. to ft. From ft. to ft.
 What is the nearest source of possible contamination:
 1 Septic tank 4 Lateral lines 7 Pit privy 10 Livestock pens 14 Abandoned water well
 2 Sewer lines 5 Cess pool 8 Sewage lagoon 11 Fuel storage 15 Oil well/Gas well
 3 Watertight sewer lines 6 Seepage pit 9 Feedyard 12 Fertilizer storage 16 Other (specify below)
 13 Insecticide storage
 Direction from well? none

FROM	TO	LITHOLOGIC LOG	FROM	TO	PLUGGING INTERVALS
0	2	Surface			
2	30	Brown clay			
30	85	Medium to coarse sand			
85	115	Brown clay			
115	140	Coarse sand			
140	183	Brown clay w/lime shells			
183	290	Good coarse sand			
290	460	Blue and brown clay w/fine sand strips			
460	583	Medium to coarse sand w/clay breakers			
583	590	Red bed			

7 CONTRACTOR'S OR LANDOWNER'S CERTIFICATION: This water well was (1) constructed (2) reconstructed, or (3) plugged under my jurisdiction and was completed on (mo/day/year) 4/13/98 and this record is true to the best of my knowledge and belief. Kansas Water Well Contractor's License No. 164 This Water Well Record was completed on (mo/day/yr) 5/4/98 under the business name of Houck Bros. Drilling Co. by (signature) M. Beard