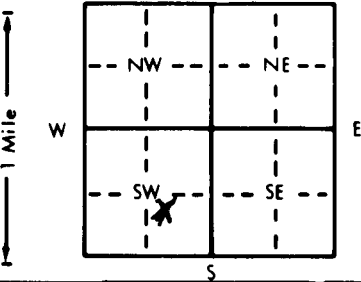


1 LOCATION OF WATER WELL:		Fraction		Section Number		Township Number		Range Number	
County: Stevens		NW 1/4 SE 1/4 SW 1/4		24		T 34 S		R 37 EW	
Distance and direction from nearest town or city street address of well if located within city? W on 2nd st. to Hooker / Moscow jct. 5 on W., 2 1/4N., and E into									
2 WATER WELL OWNER: Anadarko Pet					#1 Jennison "A"				
RR#, St. Address, Box # : P.O. Box 351					Board of Agriculture, Division of Water Resources				
City, State, ZIP Code : Liberal, Ks 67905					Application Number: 980073				
3 LOCATE WELL'S LOCATION WITH AN "X" IN SECTION BOX:					4 DEPTH OF COMPLETED WELL: 360 ft. ELEVATION:				
					Depth(s) Groundwater Encountered 1. 154 ft. 2. ft. 3. ft.				
					WELL'S STATIC WATER LEVEL 154 ft. below land surface measured on mo/day/yr 2-11-98				
					Pump test data: Well water was 252 ft. after 1 hours pumping 100 gpm				
					Est. Yield 100 gpm: Well water was ft. after hours pumping gpm				
					Bore Hole Diameter 11 in. to 252 ft., and in. to ft.				
					WELL WATER TO BE USED AS:				
					5 Public water supply 8 Air conditioning 11 Injection well				
					1 Domestic 3 Feedlot 6 Oil field water supply 9 Dewatering 12 Other (Specify below)				
					2 Irrigation 4 Industrial 7 Lawn and garden only 10 Monitoring well				
					Was a chemical/bacteriological sample submitted to Department? Yes No X; If yes, mo/day/yr sample was submitted				
					Water Well Disinfected? Yes X No				
5 TYPE OF BLANK CASING USED:									
1 Steel 3 RMP (SR) 5 Wrought iron 8 Concrete tile CASING JOINTS: Glued X Clamped									
2 PVC 4 ABS 6 Asbestos-Cement 9 Other (specify below) Welded									
7 Fiberglass Threaded									
Blank casing diameter 6 in. to 360 ft., Dia in. to ft., Dia in. to ft.									
Casing height above land surface 24 in., weight 2.902 lbs./ft. Wall thickness or gauge No. 281 SDR 21									
TYPE OF SCREEN OR PERFORATION MATERIAL:									
1 Steel 3 Stainless steel 5 Fiberglass 7 PVC 10 Asbestos-cement									
2 Brass 4 Galvanized steel 6 Concrete tile 8 RMP (SR) 11 Other (specify)									
6 None used (open hole)									
SCREEN OR PERFORATION OPENINGS ARE:									
1 Continuous slot 3 Mill slot 5 Gauzed wrapped 8 Saw cut 11 None (open hole)									
2 Louvered shutter 4 Key punched 6 Wire wrapped 9 Drilled holes									
7 Torch cut 10 Other (specify)									
SCREEN-PERFORATED INTERVALS: From 260 ft. to 360 ft., From ft. to ft.									
From ft. to ft., From ft. to ft.									
GRAVEL PACK INTERVALS: From 175 ft. to 360 ft., From ft. to ft.									
From ft. to ft., From ft. to ft.									
6 GROUT MATERIAL: 1 Neat cement 2 Cement grout 3 Bentonite 4 Other Hole Plug									
Grout Intervals: From 0 ft. to 20 ft., From ft. to ft., From ft. to ft.									
What is the nearest source of possible contamination:									
1 Septic tank 4 Lateral lines 7 Pit privy 10 Livestock pens 14 Abandoned water well									
2 Sewer lines 5 Cess pool 8 Sewage lagoon 11 Fuel storage 15 Oil well/Gas well									
3 Watertight sewer lines 6 Seepage pit 9 Feedyard 12 Fertilizer storage 16 Other (specify below)									
13 Insecticide storage									
Direction from well? East How many feet? 350									
FROM TO LITHOLOGIC LOG FROM TO PLUGGING INTERVALS									
0 7 Sand									
7 64 Sandy Clay / Clay									
64 109 Sand									
109 140 Red Clay									
140 172 Sandy Clay									
172 192 Sand									
192 220 Clay									
220 329 Sand									
329 333 Clay									
333 342 Sand									
342 360 Yellow Clay									
7 CONTRACTOR'S OR LANDOWNER'S CERTIFICATION: This water well was (1) constructed, (2) reconstructed, or (3) plugged under my jurisdiction and was completed on (mo/day/year) 2-11-98 and this record is true to the best of my knowledge and belief. Kansas Water Well Contractor's License No. KWNCL - 430 This Water Well Record was completed on (mo/day/yr) 2-11-98 under the business name of Howard Drlg. Box 806 Beaver, Ok 73932 by (signature)									
INSTRUCTIONS: Use typewriter or ball point pen. PLEASE PRESS FIRMLY and PRINT clearly. Please fill in blanks, underline or circle the correct answers. Send top three copies to Kansas Department of Health and Environment, Bureau of Water, Topeka, Kansas 66620-0001. Telephone: 913-296-5545. Send one to WATER WELL OWNER and retain one for your records.									

OFFICE USE ONLY

T

R

EW

SEC.

1/4

1/4

1/4