

1 LOCATION OF WATER WELL: County: <u>Stevens</u>	Fraction <u>NW 1/4 NE 1/4 SE 1/4</u>	Section Number <u>12</u>	Township Number T <u>34</u> S	Range Number R <u>37</u> E/W
---	---	-----------------------------	----------------------------------	---------------------------------

Distance and direction from nearest town or city street address of well if located within city?

34 mi. East 5 South 1.5 E2 WATER WELL OWNER: Larry Yoder

RR#, St. Address, Box # :

City, State, ZIP Code : Hugoton KS 67951

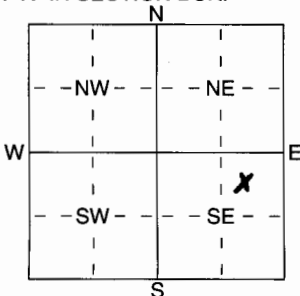
Board of Agriculture, Division of Water Resources

Application Number:

3 LOCATE WELL'S LOCATION WITH

4 DEPTH OF COMPLETED WELL 440 ft. ELEVATION:

AN "X" IN SECTION BOX:

Depth(s) Groundwater Encountered 1 205 ft. 2 ..... ft. 3 ..... ft.WELL'S STATIC WATER LEVEL 205 ft. below land surface measured on mo/day/yr 7/12/06

Pump test data: Well water was ..... ft. after ..... hours pumping ..... gpm

Est. Yield ..... gpm: Well water was ..... ft. after ..... hours pumping ..... gpm

WELL WATER TO BE USED AS: 5 Public water supply 8 Air conditioning 11 Injection well

1 Domestic 3 Feedlot 6 Oil field water supply 9 Dewatering 12 Other (Specify below)

2 Irrigation 4 Industrial 7 Domestic (lawn &amp; garden) 10 Monitoring well

Was a chemical/bacteriological sample submitted to Department? Yes ..... No X; If yes, mo/day/yr sample was submitted  
Water Well Disinfected? Yes X No

5 TYPE OF BLANK CASING USED:

5 Wrought iron

8 Concrete tile

CASING JOINTS: Glued ..... Clamped .....

1 Steel

3 RMP (SR)

6 Asbestos-Cement

9 Other (specify below)

Welded .....

2 PVC

4 ABS

7 Fiberglass

Threaded .....

Blank casing diameter 5 in. to 440 ft. Dia ..... in. to ..... ft. Dia ..... in. to ..... ft.Casing height above land surface 12 in., weight ..... lbs./ft. Wall thickness or gauge No. SDR 21

TYPE OF SCREEN OR PERFORATION MATERIAL:

1 Steel

3 Stainless Steel

5 Fiberglass

7 PVC

10 Asbestos-Cement

2 Brass

4 Galvanized Steel

6 Concrete tile

8 RMP (SR)

11 Other (Specify) .....

9 ABS

12 None used (open hole)

SCREEN OR PERFORATION OPENINGS ARE:

1 Continuous slot

3 Mill slot

5 Guazed wrapped

8 Saw cut

11 None (open hole)

2 Louvered shutter

4 Key punched

6 Wire wrapped

9 Drilled holes

7 Torch cut

10 Other (specify) ..... ft.

SCREEN-PERFORATED INTERVALS: From 360 ft. to 440 ft. From ..... ft. to ..... ft.

From ..... ft. to ..... ft. From ..... ft. to ..... ft.

GRAVEL PACK INTERVALS: From 30 ft. to 440 ft. From ..... ft. to ..... ft.

From ..... ft. to ..... ft. From ..... ft. to ..... ft.

6 GROUT MATERIAL:

1 Neat cement

2 Cement grout

3 Bentonite

4 Other .....

Grout Intervals: From 7 ft. to 30 ft. From ..... ft. to ..... ft. From ..... ft. to ..... ft.

What is the nearest source of possible contamination:

1 Septic tank

4 Lateral lines

7 Pit privy

10 Livestock pens

14 Abandoned water well

2 Sewer lines

5 Cess pool

8 Sewage lagoon

11 Fuel storage

15 Oil well/Gas well

3 Watertight sewer lines 6 Seepage pit

9 Feedyard

12 Fertilizer storage

16 Other (specify below)

13 Insecticide storage

None observed

Direction from well?

How many feet?

FROM	TO	LITHOLOGIC LOG	FROM	TO	PLUGGING INTERVALS
0	3	Top soil			
3	80	Brown Sandy clay			
80	120	Fine to med sand			
120	160	Sandy clay			
160	243	sand + sandy clay			
243	293	Fine Sand, clay streaks			
293	342	Sandy clay			
342	400	Fine Sand loose			
400	420	Fine sand + clay 50%o			
420	440	clay + sandy clay			

7 CONTRACTOR'S OR LANDOWNER'S CERTIFICATION: This water well was (1) constructed, (2) reconstructed, or (3) plugged under my jurisdiction and was completed on (mo/day/year) 7/12/06 and this record is true to the best of my knowledge and belief. Kansas Water Well Contractor's Licence No 423 This Water Well Record was completed on (mo/day/yr) 7/13/06 under the business name of Tyler Water Well Inc by (signature) Patricia S. G.