


1 LOCATION OF WATER WELL:					Fraction	Section Number	Township Number	Range Number
County: STEVENS					CENTER OF THE 1/4 SE 1/4	31	T 34 S	R 37 E/W

Distance and direction from nearest town or city street address of well if located within city?

9 SOUTH, 1½ WEST AND 1/4 MILE NORTH OF HUGOTON.

2	WATER WELL OWNER: AL BRECHEISEN	
	RR#, St. Address, Box # : STAR ROUTE, BOX BB	Board of Agriculture, Division of Water Resources
	City, State, ZIP Code : HUGOTON, KS 67951	Application Number: A04029400 03

3 LOCATE WELL'S LOCATION WITH AN "X" IN SECTION BOX: 4 DEPTH OF COMPLETED WELL... 632 ft. ELEVATION:

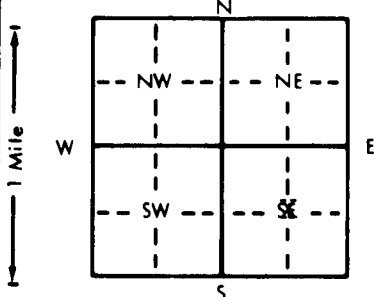

4 DEPTH OF COMPLETED WELL... 632 ... ft. ELEVATION: ...
 Depth(s) Groundwater Encountered 1. ... ft. 2. ... ft. 3. ... ft.
 WELL'S STATIC WATER LEVEL ... 15.7 ... ft. below land surface measured on mo/day/yr ... 9/14/92
 Pump test data: Well water was ... ft. after ... hours pumping ... gpm
 Est. Yield ... gpm: Well water was ... ft. after ... hours pumping ... gpm
 Bore Hole Diameter ... 2.6 ... in. to ... 6.32 ... ft., and ... in. to ... ft.
 WELL WATER TO BE USED AS: 5 Public water supply 8 Air conditioning 11 Injection well
 1 Domestic 3 Feedlot 6 Oil field water supply 9 Dewatering 12 Other (Specify below)
 2 Irrigation 4 Industrial 7 Lawn and garden only 10 Monitoring well
 Was a chemical/bacteriological sample submitted to Department? Yes ... No X; If yes, mo/day/yr sample was sub-
 mitted Water Well Disinfected? Yes ... No ...

5	TYPE OF BLANK CASING USED:		5 Wrought iron	8 Concrete tile	CASING JOINTS: Glued Clamped Welded X Threaded
	1 Steel	3 RMP (SR)	6 Asbestos-Cement	9 Other (specify below)	
	2 PVC	4 ABS	7 Fiberglass		

Blank casing diameter . . . 16 . . . in. to 632 . . . ft., Dia . . . in. to . . . ft., Dia . . . in. to . . . ft.
Casing height above land surface . . . 12 . . . in. weight 42.5 . . . lbs./ft. Wall thickness or gauge No. . . 250

TYPE OF SCREEN OR PERFORATION MATERIAL:

1 Steel	3 Stainless steel	5 Fiberglass	7 PVC	10 Asbestos-cement
2 Brass	4 Galvanized steel	6 Concrete tile	8 RMP (SR)	11 Other (specify)
			9 ABS	12 None used (open hole)

SCREEN OR PERFORATION OPENINGS ARE:

1 Continuous slot	<u>3 Mill slot</u>	5 Gauzed wrapped	8 Saw cut	11 None (open hole)
2 Louvered shutter	4 Key punched	6 Wire wrapped	9 Drilled holes	
		7 Torch cut	10 Other (specify)	

SCREEN-PERFORATED INTERVALS: From PERF 290 ft. to 490 ft. From screen 490 ft. to 570 ft.
From PERF 570 ft. to 610 ft. From SCREEN 610 ft. to 630 ft.

GRAVEL PACK INTERVALS: From 20 ft. to 63.2 ft. From ft. to ft.
From ft. to ft. From ft. to ft.

6 GROUT MATERIAL: 1 Neat cement 2 Cement grout 3 Bentonite 4 Other

Grout Intervals: From 0 ft. to 20 ft., From ft. to ft., From ft. to ft.

What is the nearest source of possible contamination:

1 Septic tank	4 Lateral lines	7 Pit privy	10 Livestock pens	14 Abandoned water well
2 Sewer lines	5 Cess pool	8 Sewage lagoon	11 Fuel storage	15 Oil well/Gas well
3 Watertight sewer lines	6 Seepage pit	9 Feedyard	12 Fertilizer storage	⑥ Other (specify below)
			13 Insecticide storage	CROPLAND - NOTHING

Direction from well?		How many feet?	IMMEDIATE VICINITY
FROM	TO		

[illegible]

7 CONTRACTOR'S OR LANDOWNER'S CERTIFICATION: This water well was (1) constructed, (2) reconstructed, or (3) plugged under my jurisdiction and was completed on (mo/day/year) 9/14/92 and this record is true to the best of my knowledge and belief. Kansas Water Well Contractor's License No. 225 This Water Well Record was completed on (mo/day/yr) 9/16/93 under the business name of KTM DRILLING, INC. by (signature) [Signature]