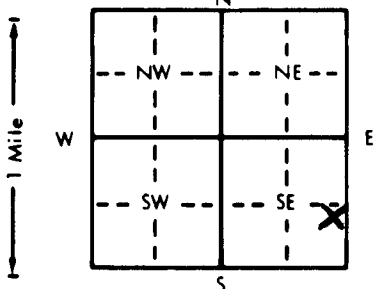


1 LOCATION OF WATER WELL: County: STEVENS	Fraction NE 1/4 SE 1/4 SE 1/4	Section Number 27	Township Number T 34 S	Range Number R 38W E/W
---	---	-----------------------------	----------------------------------	----------------------------------

Distance and direction from nearest town or city street address of well if located within city?

FROM HUGOTON 9 SOUTH TO 2nd. 4 WEST, 1 1/4 NORTH & WEST INTO LOC.

2 WATER WELL OWNER: ANADARKO PET. RR#, St. Address, Box # : P.O. BOX 351 City, State, ZIP Code : LIBERAL, KS 67905-0351	Board of Agriculture, Division of Water Resources Application Number:
--	--

3 LOCATE WELL'S LOCATION WITH AN "X" IN SECTION BOX: 	4 DEPTH OF COMPLETED WELL: 360 ft. ELEVATION: Depth(s) Groundwater Encountered 1. 145 ft. 2. 145 ft. 3. 145 ft. WELL'S STATIC WATER LEVEL 145 ft. below land surface measured on mo/day/yr 04-24-96 Pump test data: Well water was 165 ft. after 1 hours pumping 80 gpm Est. Yield 80 gpm: Well water was 165 ft. after 1 hours pumping 80 gpm Bore Hole Diameter 9 1/2 in. to 360 ft. and 360 in. to 360 ft. WELL WATER TO BE USED AS: <input checked="" type="radio"/> 1 Domestic <input type="radio"/> 3 Feedlot <input type="radio"/> 6 Oil field water supply <input type="radio"/> 9 Dewatering <input type="radio"/> 12 Other (Specify below) <input type="radio"/> 2 Irrigation <input type="radio"/> 4 Industrial <input type="radio"/> 7 Lawn and garden only <input type="radio"/> 10 Monitoring well Was a chemical/bacteriological sample submitted to Department? Yes No X ; If yes, mo/day/yr sample was submitted Water Well Disinfected? Yes X No
--	--

5 TYPE OF BLANK CASING USED: <input checked="" type="radio"/> 1 Steel <input type="radio"/> 3 RMP (SR) <input checked="" type="radio"/> 2 PVC <input type="radio"/> 4 ABS Blank casing diameter 5 in. to 360 ft. Dia 5 in. to 360 ft. Dia 5 in. to 360 ft. Casing height above land surface 24 in., weight 2.902 lbs./ft. Wall thickness or gauge No. .280 SDR 21 TYPE OF SCREEN OR PERFORATION MATERIAL: <input type="radio"/> 1 Steel <input type="radio"/> 3 Stainless steel <input type="radio"/> 5 Fiberglass <input checked="" type="radio"/> 7 PVC <input type="radio"/> 10 Asbestos-cement <input type="radio"/> 2 Brass <input type="radio"/> 4 Galvanized steel <input type="radio"/> 6 Concrete tile <input type="radio"/> 8 RMP (SR) <input type="radio"/> 11 Other (specify) <input type="radio"/> 12 None used (open hole) SCREEN OR PERFORATION OPENINGS ARE: <input type="radio"/> 1 Continuous slot <input type="radio"/> 3 Mill slot <input type="radio"/> 5 Gauzed wrapped <input checked="" type="radio"/> 8 Saw cut <input type="radio"/> 11 None (open hole) <input type="radio"/> 2 Louvered shutter <input type="radio"/> 4 Key punched <input type="radio"/> 6 Wire wrapped <input type="radio"/> 9 Drilled holes <input type="radio"/> 7 Torch cut <input type="radio"/> 10 Other (specify) SCREEN-PERFORATED INTERVALS: From 320 ft. to 360 ft. From 320 ft. to 360 ft. GRAVEL PACK INTERVALS: From 220 ft. to 360 ft. From 220 ft. to 360 ft.	CASING JOINTS: Glued X Clamped Welded Threaded
---	---

6 GROUT MATERIAL: <input checked="" type="radio"/> 1 Heat cement <input type="radio"/> 2 Cement grout <input type="radio"/> 3 Bentonite <input checked="" type="radio"/> 4 Other HOLE PLUG Grout Intervals: From 0 ft. to 16 ft. From 0 ft. to 16 ft. From 0 ft. to 16 ft. What is the nearest source of possible contamination: <input type="radio"/> 1 Septic tank <input type="radio"/> 4 Lateral lines <input type="radio"/> 7 Pit privy <input type="radio"/> 10 Livestock pens <input type="radio"/> 14 Abandoned water well <input type="radio"/> 2 Sewer lines <input type="radio"/> 5 Cess pool <input type="radio"/> 8 Sewage lagoon <input type="radio"/> 11 Fuel storage <input type="radio"/> 15 Oil well/Gas well <input type="radio"/> 3 Watertight sewer lines <input type="radio"/> 6 Seepage pit <input type="radio"/> 9 Feedyard <input type="radio"/> 12 Fertilizer storage <input type="radio"/> 16 Other (specify below) <input type="radio"/> 13 Insecticide storage Direction from well? How many feet?

FROM	TO	LITHOLOGIC LOG	FROM	TO	PLUGGING INTERVALS
0	6	SAND			
6	24	SANDY CLAY & CLAY			
24	46	CLAY			
46	137	SANDY CLAY & SAND			
137	161	SAND			
161	176	SANDY CLAY & CLAY			
176	182	SAND			
182	194	SANDY CLAY & CLAY			
194	255	SAND & CLAY STREAKS			
255	276	SAND			
276	281	SANDY CLAY			
281	344	COARSE SAND			
344	360	GOLD & RED CLAY & GRAVEL STREAKS			

7 CONTRACTOR'S OR LANDOWNER'S CERTIFICATION: This water well was <input checked="" type="radio"/> (1) constructed, <input type="radio"/> (2) reconstructed, or <input type="radio"/> (3) plugged under my jurisdiction and was completed on (mo/day/year) 04-24-96 and this record is true to the best of my knowledge and belief. Kansas Water Well Contractor's License No. KWWCL-430 This Water Well Record was completed on (mo/day/yr) 04-24-96 under the business name of HOWARD DRUG CO. BOX 806 BEAVER, OK 73932 by (signature) <i>Howard Drug Co.</i>
--