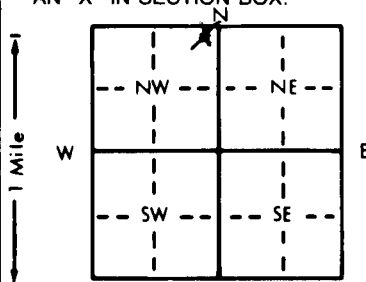


1 LOCATION OF WATER WELL: County: <b>STEVENS</b>	Fraction <b>NE 1/4 NE 1/4 NW 1/4</b>	Section Number <b>25</b>	Township Number <b>T 34 S</b>	Range Number <b>R 38 EW</b>
---	---	-----------------------------	----------------------------------	--------------------------------

Distance and direction from nearest town or city street address of well if located within city?

**Hugoton - 7 mi South - 2 1/2 West & South →**

2 WATER WELL OWNER: RR#, St. Address, Box # City, State, ZIP Code	<b>WADE Elliot</b> <b>1016 TRINDLE</b> <b>HUGOTON, KAN. 67951</b>	<b>316-544-8207</b>	Board of Agriculture, Division of Water Resources Application Number:
---	---	---------------------	--

3 LOCATE WELL'S LOCATION WITH AN "X" IN SECTION BOX: 	4 DEPTH OF COMPLETED WELL... <b>380</b> ft. ELEVATION: Depth(s) Groundwater Encountered 1... <b>208</b> ft. 2... ft. 3... ft. WELL'S STATIC WATER LEVEL... <b>208</b> ft. below land surface measured on mo/day/yr <b>6-26-98</b> Pump test data: Well water was ft. after hours pumping gpm Est. Yield gpm: Well water was ft. after hours pumping gpm Bore Hole Diameter <b>12 1/4</b> in. to <b>20</b> ft. and <b>9 1/4</b> in. to <b>380</b> ft. WELL WATER TO BE USED AS: 5 Public water supply 8 Air conditioning 11 Injection well 1 Domestic 3 Feedlot 6 Oil field water supply 9 Dewatering 12 Other (Specify below) 2 Irrigation 4 Industrial 7 Lawn and garden only 10 Monitoring well Was a chemical/bacteriological sample submitted to Department? Yes... No... <b>X</b> ... If yes, mo/day/yr sample was submitted Water Well Disinfected? Yes <b>X</b> No
--	--

5 TYPE OF BLANK CASING USED: 1 Steel 3 RMP (SR) 5 Wrought iron 8 Concrete tile 2 PVC 4 ABS 6 Asbestos-Cement 9 Other (specify below) 7 Fiberglass Blank casing diameter <b>5.56</b> in. to <b>320</b> ft. Dia. in. to ft. Dia. in. to ft. Casing height above land surface <b>30</b> in. weight <b>200</b> lbs./ft. Wall thickness or gauge No. <b>SDR-21</b> TYPE OF SCREEN OR PERFORATION MATERIAL: 1 Steel 3 Stainless steel 5 Fiberglass 8 RMP (SR) 10 Asbestos-cement 2 Brass 4 Galvanized steel 6 Concrete tile 9 ABS 11 Other (specify) 12 None used (open hole) SCREEN OR PERFORATION OPENINGS ARE: 1 Continuous slot 3 Mill slot <b>.032</b> 5 Gauzed wrapped 8 Saw cut 11 None (open hole) 2 Louvered shutter 4 Key punched 6 Wire wrapped 9 Drilled holes 7 Torch cut 10 Other (specify) SCREEN-PERFORATED INTERVALS: From <b>320</b> ft. to <b>380</b> ft. From ft. to ft. From ft. to ft. From ft. to ft. GRAVEL PACK INTERVALS: From <b>260</b> ft. to <b>380</b> ft. From ft. to ft. From ft. to ft. From ft. to ft.
--

6 GROUT MATERIAL: 1 Neat cement 2 Cement grout 3 Bentonite 4 Other Grout Intervals: From <b>5</b> ft. to <b>25</b> ft. From ft. to ft. From <b>255</b> ft. to <b>260</b> ft. What is the nearest source of possible contamination: 1 Septic tank 4 Lateral lines 7 Pit privy 10 Livestock pens 14 Abandoned water well 2 Sewer lines 5 Cess pool 8 Sewage lagoon 11 Fuel storage 15 Oil well/Gas well 3 Watertight sewer lines 6 Seepage pit 9 Feedyard 12 Fertilizer storage 16 Other (specify below) 13 Insecticide storage Direction from well? <b>Southeast</b> How many feet? <b>120</b>
---

FROM	TO	LITHOLOGIC LOG	FROM	TO	PLUGGING INTERVALS
0	2	Topsoil	291	304	Brown sandy clay w/ coarse sand strks.
2	17	Fine sand & tan sandy clay			
17	44	Tan sandy clay	304	326	Coarse sand-sm. gravel w/ tan sandy clay
44	50	Fine sand			
50	118	Tan sandy clay w/ fine sand streaks	326	374	Sand and gravel w/ tan, red, & yellow sandy clay
118	172	Tan sandy clay & sandstone	374	380	Sand & gravel w/ blue & yellow sandy clay
172	198	Brown clay w/ fine sand strks.			
198	207	Tan sandy clay			
207	215	Brown sandy clay w/ sand strks			
215	256	Med. sand w/ brown sandy clay streaks			
256	268	Brown clay			
268	272	Brown sandy clay			
272	291	med. to coarse sand			

7 CONTRACTOR'S OR LANDOWNER'S CERTIFICATION: This water well was (1) constructed, (2) reconstructed, or (3) plugged under my jurisdiction and was completed on (mo/day/year) <b>6-26-98</b> and this record is true to the best of my knowledge and belief. Kansas Water Well Contractor's License No. <b>600A</b> This Water Well Record was completed on (mo/day/yr) <b>6-27-98</b> under the business name of <b>CRAMER DRG. Co.</b> by (signature) <b>Roy Cramer</b>
--