

1 LOCATION OF WATER WELL: Fraction SW 1/4 SW 1/4 SW 1/4 Section Number 13 Township Number T 34 S Range Number R 38 E
 County: Stevens

Distance and direction from nearest town or city street address of well if located within city?

@ the intersection of County roads 9 & G

2 WATER WELL OWNER: MID America Cattle Co. c/o Walter Beesley

RR#, St. Address, Box # Box 818


Board of Agriculture, Division of Water Resource

City, State, ZIP Code Hagerton, KS 67951

Application Number:

3 LOCATE WELL'S LOCATION WITH

AN "X" IN SECTION BOX:

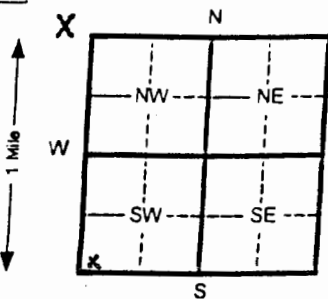

4 DEPTH OF COMPLETED WELL

280 ft. ELEVATION:

Depth(s) Groundwater Encountered 1 _____ ft. 2 _____ ft. 3 _____ ft.

WELL'S STATIC WATER LEVEL 265 ft. below land surface measured on mo/day/yr 3-12-13

Pump test data: Well water was _____ ft. after _____ hours pumping _____ gpm

Est. Yield _____ gpm: Well water was _____ ft. after _____ hours pumping _____ gpm

Bore Hole Diameter _____ in. to _____ ft. and _____ in. to _____ ft.

WELL WATER TO BE USED AS: 5 Public water supply 8 Air conditioning 11 Injection well

1 Domestic 3 Feed lot 6 Oil field water supply 9 Dewatering 12 Other (Specify below)

2 Irrigation 4 Industrial 7 Lawn and garden (domestic) 10 Monitoring well LIVESTOCK

Was a chemical/bacteriological sample submitted to Department? Yes _____ No ☒ If yes, mo/day/yr sample was submitted

Water Well Disinfected? Yes ☒ No

5 TYPE OF BLANK CASING USED:

Steel 3 RMP (SR)
2 PVC 4 ABS

5 Wrought Iron 8 Concrete tile
6 Asbestos-Cement 9 Other (specify below)
7 Fiberglass

CASING JOINTS: Glued _____ Clamped _____
Welded _____
Threaded _____

Blank casing diameter 5 in. to _____ ft., Dia _____ in. to _____ ft., Dia _____ in. to _____ ft.

Casing height above land surface _____ in., weight _____ lbs./ft. Wall thickness or gauge No. _____

TYPE OF SCREEN OR PERFORATION MATERIAL:

1 Steel 3 Stainless steel 5 Fiberglass 7 PVC 10 Asbestos-cement
2 Brass 4 Galvanized steel 6 Concrete tile 8 RMP (SR) 11 Other (specify)
12 None used (open hole)

SCREEN OR PERFORATION OPENINGS ARE:

1 Continuous slot 3 Mill slot 5 Gauzed wrapped 8 Saw cut 11 None (open hole)
2 Louvered shutter 4 Key punched 6 Wire wrapped 9 Drilled holes
7 Torch cut 10 Other (specify)

SCREEN-PERFORATED INTERVALS: From _____ ft. to _____ ft. From _____ ft. to _____ ft.

GRAVEL PACK INTERVALS: From _____ ft. to _____ ft. From _____ ft. to _____ ft.

6 GROUT MATERIAL: 1 Neat cement 2 Cement grout 3 Bentonite 4 Other

Grout Intervals From _____ ft. to _____ ft. From _____ ft. to _____ ft. From _____ ft. to _____ ft.

What is the nearest source of possible contamination:

1 Septic tank 4 Lateral lines 7 Pit privy 10 Livestock pens 14 Abandoned water well
2 Sewer lines 5 Cess pool 8 Sewage lagoon 11 Fuel storage 15 Oil well/ Gas well
3 Watertight sewer lines 6 Seepage pit 9 Feedyard 12 Fertilizer storage 16 Other (specify below)
13 Insecticide storage

Direction from well?

How many feet?

FROM TO CODE LITHOLOGIC LOG FROM TO PLUGGING INTERVALS

280 180 Gravel Fill
180 170 Bentonite Plug
170 15 Compacted Fill
15 5 Cement Plug

7 CONTRACTOR'S OR LANDOWNER'S CERTIFICATION: This water well was (1) constructed, (2) reconstructed, or (3) plugged under my jurisdiction and was

completed on (mo/day/yr) 3-12-13 and this record is true to the best of my knowledge and belief. Kansas

Water Well Contractor's License No. 973

This Water Well Record was completed on (mo/day/yr) 3-13-13

under the business name of Tyler Water Well Serv by (signature) Richard Hoffman

INSTRUCTIONS: Please fill in blanks and circle the correct answers. Send three copies to Kansas Department of Health and Environment, Bureau of Water, Topeka, Kansas 66601. 785-296-5545. Send one to WATER WELL OWNER and retain one for your records.