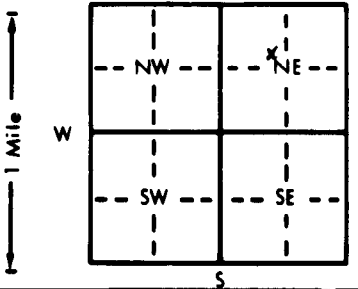


1 LOCATION OF WATER WELL:		Fraction	Section Number	Township Number	Range Number		
County: Stevens		SE ¼ NW ¼ NE ¼	10	T 34 S	R 38W E/W		
Distance and direction from nearest town or city street address of well if located within city? Hugoton, Kansas - 4 1/4 miles South - 4 1/4 miles West into location.							
2 WATER WELL OWNER: John Ertz Mobil Oil Corp./ Unit 19 RR#, St. Address, Box #: Route HC-01 Board of Agriculture, Division of Water Resources City, State, ZIP Code: Hugoton, KS Application Number: T 88-106							
3 LOCATE WELL'S LOCATION WITH AN "X" IN SECTION BOX:		4 DEPTH OF COMPLETED WELL 340' ft. ELEVATION:					
		Depth(s) Groundwater Encountered 1 169' ft. 2 ft. 3 ft. WELL'S STATIC WATER LEVEL 169' ft. below land surface measured on mo/day/yr Pump test data: Well water was ft. after hours pumping gpm Est. Yield 100 gpm: Well water was ft. after hours pumping gpm Bore Hole Diameter 11" in. to 340' ft. and in. to ft. WELL WATER TO BE USED AS: 1 Domestic 3 Feedlot 6 Oil field water supply 8 Air conditioning 11 Injection well 2 Irrigation 4 Industrial 7 Lawn and garden only 9 Dewatering 12 Other (Specify below) Was a chemical/bacteriological sample submitted to Department? Yes No X; If yes, mo/day/yr sample was submitted Water Well Disinfected? Yes X No					
5 TYPE OF BLANK CASING USED: 1 Steel 3 RMP (SR) 5 Wrought iron 8 Concrete tile CASING JOINTS: Glued Clamped 2 PVC 4 ABS 6 Asbestos-Cement 9 Other (specify below) Welded 7 Fiberglass Threaded Blank casing diameter 6.625 in. to 340' ft. Dia. in. to ft. Dia. in. to ft. Casing height above land surface -48" in. weight 3.71 lbs./ft. Wall thickness or gauge No. 280 TYPE OF SCREEN OR PERFORATION MATERIAL: 1 Steel 3 Stainless steel 5 Fiberglass 7 PVC 10 Asbestos-cement 2 Brass 4 Galvanized steel 6 Concrete tile 8 RMP (SR) 11 Other (specify) 9 ABS 12 None used (open hole) SCREEN OR PERFORATION OPENINGS ARE: 1 Continuous slot 3 Mill slot 5 Gauzed wrapped 6 Saw cut 11 None (open hole) 2 Louvered shutter 4 Key punched 6 Wire wrapped 9 Drilled holes 7 Torch cut 10 Other (specify) SCREEN-PERFORATED INTERVALS: From 220' ft. to 340' ft. From ft. to ft. GRAVEL PACK INTERVALS: From 25 ft. to 155 ft. From 165 ft. to 340 ft. From ft. to ft. From ft. to ft.							
6 GROUT MATERIAL: 1 Neat cement 2 Cement grout 3 Bentonite 4 Other Grout Intervals: From 4 ft. to 10 ft. From 10 ft. to 25 ft. From 155 ft. to 165 ft. What is the nearest source of possible contamination: 1 Septic tank 4 Lateral lines 7 Pit privy 10 Livestock pens 14 Abandoned water well 2 Sewer lines 5 Cess pool 8 Sewage lagoon 11 Fuel storage 15 Oil well/Gas well 3 Watertight sewer lines 6 Seepage pit 9 Feedyard 12 Fertilizer storage 16 Other (specify below) 13 Insecticide storage Direction from well? Southeast How many feet? 300'							
FROM	TO	LITHOLOGIC LOG		FROM	TO	LITHOLOGIC LOG	
0	4	Dirt .79 cu. feet of dirt					
4	10	Neet Cement 1.18 cu. feet of cement					
10	25	Bentonite Grout 2.94 cu. feet of bentonite grout					
25	155	Chlorinated Gravel 25.52 cu. feet of chlorinated gravel					
155	165	Bentonite Grout 1.96 cu. feet of bentonite grout					
165	340	Chlorinated Gravel 34.35 cu. feet of chlorinated gravel					
7 CONTRACTOR'S OR LANDOWNER'S CERTIFICATION: This water well was (1) constructed, (2) reconstructed, or (3) plugged under my jurisdiction and was completed on (mo/day/year) 05/06/88 and this record is true to the best of my knowledge and belief. Kansas Water Well Contractor's License No. 118 This Water Well Record was completed on (mo/day/yr) 05/11/88 under the business name of Carlile Water Well Service, Inc. by (signature) [Signature]							
INSTRUCTIONS: Use typewriter or ball point pen. PLEASE PRESS FIRMLY and PRINT clearly. Please fill in blanks, underline or circle the correct answers. Send top three copies to Kansas Department of Health and Environment, Bureau of Water Protection, Topeka, Kansas 66620-7320, Telephone: 913-862-9360. Send one to WATER WELL OWNER and retain one for your records.							