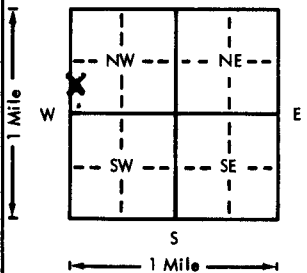


USE TYPEWRITER OR BALL
POINT PEN-PRESS FIRMLY,
PRINT CLEARLY.

WATER WELL RECORD
KSA 82a-1201-1215

Kansas Department of Health and
Environment-Division of Environment
(Water well Contractors)
Topeka, Kansas 66620

1. Location of well:		County Stevens	Fraction NW 1/4 Sec 7 1/4 NW 1/4	Section number 10	Township number T 34 S	Range number R 38 E/W
2. Distance and direction from nearest town or city: 5 WEST OF HUGOTON			3. Owner of well: John Ertz C.R. ERTZ ESTATE R.R. or street: 96 John Ertz Box 97 City, state, zip code: STATE GORTON, KAN 67951			
4. Locate with "X" in section below:		Sketch map:		6. Bore hole dia. 8 1/2 in. Completion date 5-22-76 Well depth 554 ft.		
				7. <input checked="" type="checkbox"/> Cable tool <input checked="" type="checkbox"/> Rotary <input type="checkbox"/> Driven <input type="checkbox"/> Dug <input type="checkbox"/> Hollow rod <input type="checkbox"/> Jetted <input type="checkbox"/> Bored <input type="checkbox"/> Reverse rotary		
5. Type and color of material		From	To	8. Use: <input checked="" type="checkbox"/> Domestic <input type="checkbox"/> Public supply <input type="checkbox"/> Industry <input checked="" type="checkbox"/> Irrigation <input type="checkbox"/> Air conditioning <input type="checkbox"/> Stock <input type="checkbox"/> Lawn <input type="checkbox"/> Oil field water <input type="checkbox"/> Other		
Overburden		0	2	9. Casing: Material Steel Height: Above or below Threaded <input type="checkbox"/> Welded <input checked="" type="checkbox"/> Surface 12 in. RMP <input type="checkbox"/> PVC <input type="checkbox"/> Weight 42.5 lbs./ft. Dia. 1 1/2 in. to 554 ft. depth Wall Thickness: inches or Dia. <input type="checkbox"/> in. to <input type="checkbox"/> ft. depth gage No. 250		
Top Soil		2	193	10. Screen: Manufacturer's name L.B. Foster Type Steel Dia. 1 1/2 Slot/gauze 1/8 Length 277 Set between 252 ft. and 530 ft. 550 ft. and 554 ft. Gravel pack? <input checked="" type="checkbox"/> Size range of material 1/2-1/4		
Clay		193	260	11. Static water level: 183 ft. below land surface Date 5/22/76 mo./day/yr.		
Coarse Sd. & Clay		260	280	12. Pumping level below land surfaces: NA ft. after hrs. pumping g.p.m. ft. after hrs. pumping g.p.m. Estimated maximum yield g.p.m.		
Sand & Gravel		280	340	13. Water sample submitted: NA mo./day/yr. Yes <input checked="" type="checkbox"/> No <input type="checkbox"/> Date		
Med. Sd., Gravel & Clay Strks.		340	420	14. Well head completion: NA <input checked="" type="checkbox"/> Pitless adapter _____ Inches above grade <input checked="" type="checkbox"/> Well grouted? Yes With: <input checked="" type="checkbox"/> Neat cement <input type="checkbox"/> Bentonite <input type="checkbox"/> Concrete Depth: From 0 ft. to 10 ft.		
Sand & Gravel w/Clay Strks.		420	550	16. Nearest source of possible contamination: ft. _____ Direction _____ Type _____ Well disinfected upon completion? Yes <input checked="" type="checkbox"/> No <input type="checkbox"/>		
Red Bed		550	553	17. Pump: <input checked="" type="checkbox"/> Not installed Manufacturer's name _____ Model number _____ HP _____ Volts _____ Length of drop pipe _____ ft. capacity _____ g.p.m. Type: <input type="checkbox"/> Submersible <input type="checkbox"/> Turbine <input type="checkbox"/> Jet <input type="checkbox"/> Reciprocating <input type="checkbox"/> Centrifugal <input type="checkbox"/> Other		
18. Elevation:		19. Remarks:		20. Water well contractor's certification: This well was drilled under my jurisdiction and this report is true to the best of my knowledge and belief. KTM DRILLING, INC. 225 Business name Box 1385 Guymon, Okla. License No. _____ Address _____ Signed John Ertz Date 6/7/76 Authorized representative		