#3 Beavers #1 Unit

WATER WELL RECORD Form WWC-5 KSA 82a-1212

1 LOCATION OF WATER WELL: County: Stevens | Fraction: NW ¼ SW ¼ SW ¼ | Section Number: 14 | Township Number: T 34S S | Range Number: R 38W E/W

Distance and direction from nearest town or city street address of well if located within city? Hugoton, Kansas - 7 miles South - 3 3/4 miles West - North into location.

2 WATER WELL OWNER: Paul Gould
RR#, St. Address, Box # : Rt 2
City, State, ZIP Code : Hugoton, KS 67951

Mobil Oil Corp./ Zenith #6
Board of Agriculture, Division of Water Resources
Application Number: T 88-154

3 LOCATE WELL'S LOCATION WITH AN "X" IN SECTION BOX:

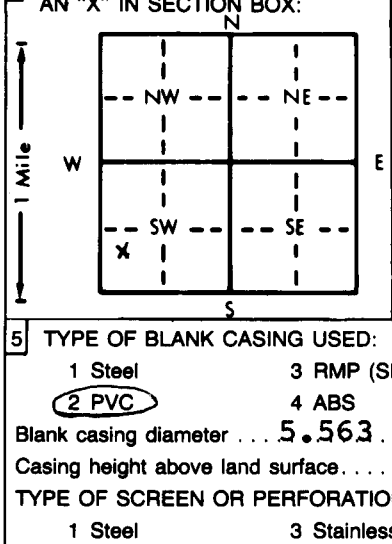

4 DEPTH OF COMPLETED WELL 300 ft. ELEVATION:
Depth(s) Groundwater Encountered 1. 175 ft. 2. ft. 3. ft.
WELL'S STATIC WATER LEVEL 175 ft. below land surface measured on mo/day/yr 03/25/88
Pump test data: Well water was ft. after hours pumping gpm
Est. Yield 100 gpm: Well water was ft. after hours pumping gpm
Bore Hole Diameter 9 in. to 300 ft., and in. to ft.
WELL WATER TO BE USED AS: 5 Public water supply 8 Air conditioning 11 Injection well
1 Domestic 3 Feedlot (6 Oil field water supply) 9 Dewatering 12 Other (Specify below)
2 Irrigation 4 Industrial 7 Lawn and garden only 10 Observation well
Was a chemical/bacteriological sample submitted to Department? Yes No X; If yes, mo/day/yr sample was submitted
Water Well Disinfected? Yes X No

5 TYPE OF BLANK CASING USED: 5 Wrought iron 8 Concrete tile CASING JOINTS: Glued Clamped
1 Steel 3 RMP (SR) 6 Asbestos-Cement 9 Other (specify below) Welded
(2 PVC) 4 ABS 7 Fiberglass Threaded
Blank casing diameter 5.563 in. to 200 ft., Dia in. to ft., Dia in. to ft.
Casing height above land surface 28 in., weight 2.93 lbs./ft. Wall thickness or gauge No. .265

TYPE OF SCREEN OR PERFORATION MATERIAL: (7 PVC) 10 Asbestos-cement
1 Steel 3 Stainless steel 5 Fiberglass 8 RMP (SR) 11 Other (specify)
2 Brass 4 Galvanized steel 6 Concrete tile 9 ABS 12 None used (open hole)

SCREEN OR PERFORATION OPENINGS ARE: 5 Gauzed wrapped (8 Saw cut) 11 None (open hole)
1 Continuous slot 3 Mill slot 6 Wire wrapped 9 Drilled holes
2 Louvered shutter 4 Key punched 7 Torch cut 10 Other (specify)

SCREEN-PERFORATED INTERVALS: From 200 ft. to 300 ft., From ft. to ft.
From ft. to ft., From ft. to ft.

GRAVEL PACK INTERVALS: From 20 ft. to 120 ft., From 130 ft. to 300 ft.
From ft. to ft., From ft. to ft.

6 GROUT MATERIAL: (1 Neat cement) 2 Cement grout (3 Bentonite) 4 Other
Grout Intervals: From 0 ft. to 20 ft., From 120 ft. to 130 ft., From ft. to ft.

What is the nearest source of possible contamination:
1 Septic tank 4 Lateral lines 7 Pit privy 10 Livestock pens 14 Abandoned water well
2 Sewer lines 5 Cess pool 8 Sewage lagoon 11 Fuel storage (15 Oil well/Gas well)
3 Watertight sewer lines 6 Seepage pit 9 Feedyard 12 Fertilizer storage 16 Other (specify below)
13 Insecticide storage
Direction from well? South How many feet? 165'

FROM	TO	LITHOLOGIC LOG	FROM	TO	LITHOLOGIC LOG
0	2	Surface	225	245	15% Clay - 80% Med. to large sand - 5% Gravel
2	10	Clay	245	260	40% Clay - 53% Med. to large sand - 7% Gravel
10	43	Sandy Clay	260	280	15% Clay - 80% Med. to large sand - 5% Gravel
43	85	Clay	280	300	95% Med. to large sand - 5% Gravel
85	100	40% Fine Sand - 50% Med. to large sand - 10% Gravel			
100	145	Sandy Clay			
145	155	40% Fine Sand - 60% Sandy clay			
155	160	White Sand Stone			
160	180	Sandy Clay			
180	200	20% Med. to large sand - 80% Sandy Clay			
200-	225	95% Med. to large sand - 5% Gravel			

7 CONTRACTOR'S OR LANDOWNER'S CERTIFICATION: This water well was (1) constructed, (2) reconstructed, or (3) plugged under my jurisdiction and was completed on (mo/day/year) 03/25/88 and this record is true to the best of my knowledge and belief. Kansas Water Well Contractor's License No. 118 This Water Well Record was completed on (mo/day/yr) 03/25/88 under the business name of Carlile Water Well Service, Inc. by (signature)

INSTRUCTIONS: Use typewriter or ball point pen. *PLEASE PRESS FIRMLY* and *PRINT* clearly. Please fill in blanks, underline or circle the correct answers. Send top three copies to Kansas Department of Health and Environment, Bureau of Water Protection, Topeka, Kansas 66620-7320, Telephone: 913-862-9360. Send one to WATER WELL OWNER and retain one for your records.

OFFICE USE ONLY T R E/W SEC. ¼ ¼ ¼