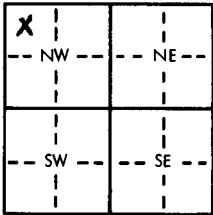
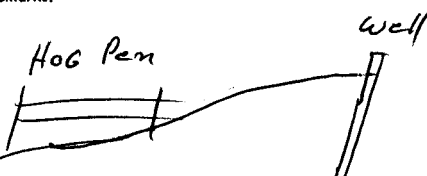


USE TYPEWRITER OR BALL  
POINT PEN-PRESS FIRMLY,  
PRINT CLEARLY.

WATER WELL RECORD  
KSA 82a-1201-1215

Kansas Department of Health and  
Environment-Division of Environment  
(Water well Contractors)  
Topeka, Kansas 66620

1. Location of well:	County <b>Storers</b>	Fraction <b>NW 1/4 NW 1/4 NW 1/4</b>	Section number <b>29</b>	Township number <b>T 34 S</b>	Range number <b>R 38 E/W</b>
2. Distance and direction from nearest town or city: <b>7 west 6 1/4 South</b>			3. Owner of well: <b>Mr. Jim Clinesmith</b> R. R. City, state, zip code: <b>Hugoton, KA 67954</b>		
Street address of well location if in city: <b>of Hugoton</b>					
4. Locate with "X" in section below: N W E S 1 Mile			Sketch map: 6. Bore hole dia. <b>10</b> in. Completion date <b>2-28-79</b> Well depth <b>420</b> ft.		
			7. <input checked="" type="checkbox"/> Cable tool <input checked="" type="checkbox"/> Rotary <input type="checkbox"/> Driven <input type="checkbox"/> Dug <input type="checkbox"/> Hollow rod <input type="checkbox"/> Jetted <input type="checkbox"/> Bored <input type="checkbox"/> Reverse rotary		
			8. Use: <input checked="" type="checkbox"/> Domestic <input type="checkbox"/> Public supply <input type="checkbox"/> Industry <input type="checkbox"/> Irrigation <input type="checkbox"/> Air conditioning <input type="checkbox"/> Stock <input type="checkbox"/> Lawn <input type="checkbox"/> Oil field water <input type="checkbox"/> Other		
5. Type and color of material			9. Casing: Material <b>304 40</b> Height: <b>Above or below</b> Threaded <input type="checkbox"/> Welded <input type="checkbox"/> Surface <b>18"</b> in. RMP <input type="checkbox"/> PVC <input checked="" type="checkbox"/> Weight <input type="checkbox"/> lbs./ft. Dia. <b>5</b> in. to <b>420</b> ft. depth Wall Thickness: inches or Dia. <input type="checkbox"/> in. to <input type="checkbox"/> ft. depth Gauge No. <b>258</b>		
Sand Tan fine			10. Screen: Manufacturer's name <b>Slocum</b> Type <b>Saw cut</b> Dia. <b>5"</b> Slot/gauze <b>1/4</b> Length <b>40'</b> Set between <b>390</b> ft. and <b>420</b> ft. Gravel pack? <input checked="" type="checkbox"/> Size range of material <b>1/4 - 1/2</b>		
" " " + silts brown			11. Static water level: <b>235</b> ft. below land surface Date <b>2-28-79</b>		
Silts brown compact w/caliche nodules			12. Pumping level below land surfaces: <b>240</b> ft. after <b>2</b> hrs. pumping <b>13</b> g.p.m. ft. after <input type="checkbox"/> hrs. pumping <input type="checkbox"/> g.p.m. Estimated maximum yield <b>9</b> g.p.m.		
Sand brown coarse			13. Water sample submitted: <input type="checkbox"/> Yes <input checked="" type="checkbox"/> No Date <input type="checkbox"/>		
Silts compact redish w/some sand			14. Well head completion: <input checked="" type="checkbox"/> Pitless adapter <b>18</b> inches above grade		
Sand + Gravel coarse calcified			15. Well grouted? <input checked="" type="checkbox"/> With: <input type="checkbox"/> Neat cement <input type="checkbox"/> Bentonite <input checked="" type="checkbox"/> Concrete Depth: From <b>4</b> ft. to <b>10</b> ft.		
Clays Tan			16. Nearest source of possible contamination: ft. <b>50</b> Direction <b>East</b> Type <b>Hog Pen</b> Well disinfected upon completion? <input checked="" type="checkbox"/> Yes <input type="checkbox"/> No		
" + Silts Tan w/silt ball fine sand			17. Pump: Manufacturer's name <b>Flint + Walling</b> Model number <b>10BA 15</b> HP <b>1</b> Volts <b>230</b> Length of drop pipe <b>280</b> ft. capacity <b>13</b> g.p.m. Type: <input checked="" type="checkbox"/> Submersible <input type="checkbox"/> Turbine <input type="checkbox"/> Jet <input type="checkbox"/> Reciprocating <input type="checkbox"/> Centrifugal <input type="checkbox"/> Other		
Silt balls w/sand coarse Loose			20. Water well contractor's certification: This well was drilled under my jurisdiction and this report is true to the best of my knowledge and belief. <b>Slocum Drilling</b> <b>127</b> Business name License No. Address <b>Hugoton Ka</b> Signed <b>Paul Slocum</b> Date <b>4-9</b> Authorized representative		
" " w/ " silty					
" " w/ " coarse					
Sand coarse					
" " w/some clay balls					
(Use a second sheet if needed)					
18. Elevation:		19. Remarks: 			
Topography: <input checked="" type="checkbox"/> Hill <input type="checkbox"/> Slope <input type="checkbox"/> Upland <input type="checkbox"/> Valley					