WATER WELL RECORD Form WWC-5 KSA 82a-1212

1 LOCATION OF WATER WELL: County: MORTON	Fraction: NE ¼ NE ¼ NW ¼	Section Number: 32	Township Number: T 34 S	Range Number: R 39 E/W

Distance and direction from nearest town or city street address of well if located within city?
FROM ROLLA FIVE AND ONE-HALF (5½) MILES SOUTH AND ONE AND ONE-HALF (1½) MILES EAST.

2 WATER WELL OWNER: CLARK LITTELL
RR#, St. Address, Box # : 109 WEST 6TH
City, State, ZIP Code : HUGOTON, KS 67951

Board of Agriculture, Division of Water Resources
Application Number: 41,782

3 LOCATE WELL'S LOCATION WITH AN "X" IN SECTION BOX:

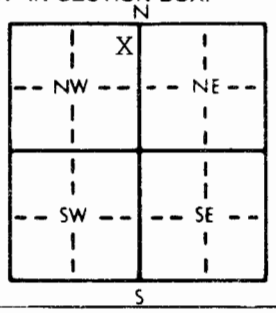

4 DEPTH OF COMPLETED WELL 480 ft. ELEVATION:
Depth(s) Groundwater Encountered 1. ft. 2. ft. 3. ft.
WELL'S STATIC WATER LEVEL 156 ft. below land surface measured on mo/day/yr 11/17/95
Pump test data: Well water was ft. after hours pumping gpm
Est. Yield gpm: Well water was ft. after hours pumping gpm
Bore Hole Diameter 26 in. to 480 ft., and in. to ft.
WELL WATER TO BE USED AS: 1 Domestic 2 Irrigation 3 Feedlot 4 Industrial 5 Public water supply 6 Oil field water supply 7 Lawn and garden only 8 Air conditioning 9 Dewatering 10 Monitoring well 11 Injection well 12 Other (Specify below)
Was a chemical/bacteriological sample submitted to Department? Yes No X ; If yes, mo/day/yr sample was submitted
Water Well Disinfected? Yes No

5 TYPE OF BLANK CASING USED: 1 Steel 2 PVC 3 RMP (SR) 4 ABS 5 Wrought iron 6 Asbestos-Cement 7 Fiberglass 8 Concrete tile 9 Other (specify below)
CASING JOINTS: Glued Clamped Welded X Threaded
Blank casing diameter 16 in. to 480 ft., Dia in. to ft., Dia in. to ft.
Casing height above land surface 12 in., weight 42.5 lbs./ft. Wall thickness or gauge No. .250
TYPE OF SCREEN OR PERFORATION MATERIAL: 1 Steel 2 Brass 3 Stainless steel 4 Galvanized steel 5 Fiberglass 6 Concrete tile 7 PVC 8 RMP (SR) 9 ABS 10 Asbestos-cement 11 Other (specify) 12 None used (open hole)
SCREEN OR PERFORATION OPENINGS ARE: 1 Continuous slot 2 Louvered shutter 3 Mill slot 4 Key punched 5 Gauzed wrapped 6 Wire wrapped 7 Torch cut 8 Saw cut 9 Drilled holes 10 Other (specify) 11 None (open hole)
SCREEN-PERFORATED INTERVALS: From PERF. 320 ft. to 380 ft., From SCREEN 380 ft. to 400 ft
From PERF. 400 ft. to 440 ft., From SCREEN 440 ft. to 460 ft.
GRAVEL PACK INTERVALS: From 20 ft. to 480 ft., From PERF. 460 ft. to 480 ft.
From ft. to ft., From ft. to ft.

6 GROUT MATERIAL: 1 Neat cement 2 Cement grout 3 Bentonite 4 Other
Grout Intervals: From 0 ft. to 20 ft., From ft. to ft., From ft. to ft.
What is the nearest source of possible contamination: 1 Septic tank 2 Sewer lines 3 Watertight sewer lines 4 Lateral lines 5 Cess pool 6 Seepage pit 7 Pit privy 8 Sewage lagoon 9 Feedyard 10 Livestock pens 11 Fuel storage 12 Fertilizer storage 13 Insecticide storage 14 Abandoned water well 15 Oil well/Gas well 16 Other (specify below) CROPLAND-NOTHING
Direction from well? How many feet? IMMEDIATE VICINITY

FROM	TO	LITHOLOGIC LOG	FROM	TO	PLUGGING INTERVALS
0	220	SURFACE, SAND & CLAY			
220	280	FINE SNAD			
280	380	SANDY BROWN CLAY			
380	476	FINE TO MED. SAND			
476	500	REDDISH, BROWN CLAY			

7 CONTRACTOR'S OR LANDOWNER'S CERTIFICATION: This water well was (1) constructed, (2) reconstructed, or (3) plugged under my jurisdiction and was completed on (mo/day/year) 11/17/95 and this record is true to the best of my knowledge and belief. Kansas Water Well Contractor's License No. 225 This Water Well Record was completed on (mo/day/yr) 1/12/96
under the business name of KTM DRILLING, INC. by (signature) [signature]

INSTRUCTIONS: Use typewriter or ball point pen. *PLEASE PRESS FIRMLY* and *PRINT* clearly. Please fill in blanks, underline or circle the correct answers. Send top three copies to Kansas Department of Health and Environment, Bureau of Water, Topeka, Kansas 66620-0001. Telephone: 913-296-5545. Send one to WATER WELL OWNER and retain one for your records.

OFFICE USE ONLY T. R E/W SEC. ¼ ¼ ¼ ¼