


1 LOCATION OF WATER WELL:		Fraction		Section Number		Township Number		Range Number		
County:	STEVENS	SW	1/4	SW	1/4	SE	1/4	24	T 34 S	R 39 E/W

FROM FETERITA SIX (6) MILES SOUTH & 1½ MILES WEST.

Application Number: 42,245

Water Well Disinfected? Yes No

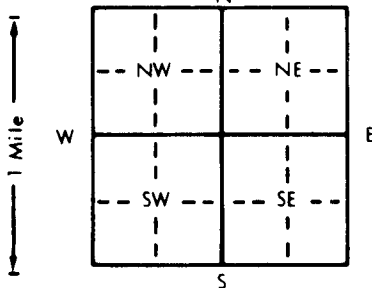

IMMEDIATE VICINITY

[illegible]

by (signature)

INSTRUCTIONS: Use typewriter or ball point pen. PLEASE PRESS FIRMLY and PRINT clearly. Please fill in blanks, underline or circle the correct answers. Send top three copies to Kansas Department of Health and Environment, Bureau of Water, Topeka, Kansas 66620-0001. Telephone: 913-296-5545. Send one to WATER WELL OWNER and retain one for your records.