

**CORRECTION(S) TO WATER WELL RECORD (WWC-5)**

(to rectify lacking or incorrect information)

County: Stevens

Location listed as:

Section-Township-Range: 24-385-39

Fraction (  $\frac{1}{4}$   $\frac{1}{4}$   $\frac{1}{4}$ ): NW NW NW

Location changed to:

24-345-39 W

NW NW NW

Other changes: Initial statements: 11 West 4 South & 2 West of Hugoton.

Changed to: From Hugoton: 7 mi. W/SW on Hwy 56, 4 mi. S.,  
2 mi. W., 1 mi. S.

Comments: \_\_\_\_\_

verification method: Phone call to well contractor, and Hugoton, Feterita,  
Hugoton SW, & Rolla SE 1:24,000 topo. maps.

initials: DRJ date: 12/16/2005

submitted by: Kansas Geological Survey, Data Resources Library, 1930 Constant Ave., Lawrence, KS 66047-3726

to: Kansas Dept of Health & Environment, Bureau of Water, 1000 SW Jackson, Suite 420, Topeka, KS 66612-1367.

1 LOCATION OF WATER WELL:	Fraction	Section Number	Township Number	Range Number
County: <b>Stevens</b>	<b>NW</b> $\frac{1}{4}$ <b>NW</b> $\frac{1}{4}$ <b>NW</b> $\frac{1}{4}$	<b>24</b>	<b>T 38 S</b>	<b>R 39 E/W</b>

Distance and direction from nearest town or city street address of well if located within city?

**11 West 4 South & 2 West of Hugoton**2 WATER WELL OWNER: **Kurt Hall**RR#, St. Address, Box #: **205 3 rd Ave**

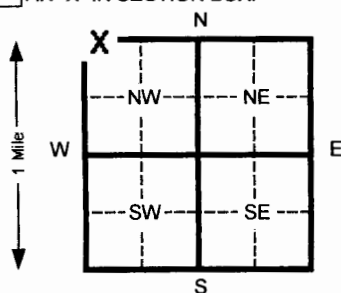
Board of Agriculture, Division of Water Resources

City, State, ZIP Code: **Rolla, KS 67954**

Application Number:

3 LOCATE WELL'S LOCATION WITH AN "X" IN SECTION BOX:

4 DEPTH OF COMPLETED WELL

**453** ft. ELEVATION:Depth(s) Groundwater Encountered 1 **190** ft. 2 \_\_\_\_\_ ft. 3 \_\_\_\_\_ ft.WELL'S STATIC WATER LEVEL **190** ft. below land surface measured on mo/day/yr **11/10/05**

Pump test data: Well water was \_\_\_\_\_ ft. after \_\_\_\_\_ hours pumping \_\_\_\_\_ gpm

Est. Yield \_\_\_\_\_ gpm: Well water was \_\_\_\_\_ ft. after \_\_\_\_\_ hours pumping \_\_\_\_\_ gpm

Bore Hole Diameter **10** in. to \_\_\_\_\_ ft. and \_\_\_\_\_ in. to \_\_\_\_\_ ft.

WELL WATER TO BE USED AS: 5 Public water supply 8 Air conditioning 11 Injection well

1 Domestic 3 Feed lot 6 Oil field water supply 9 Dewatering 12 Other (Specify below)

2 Irrigation 4 Industrial 7 Lawn and garden (domestic) 10 Monitoring well

Was a chemical/bacteriological sample submitted to Department? Yes \_\_\_\_\_ No **X** If yes, mo/day/yr sample was submittedWater Well Disinfected? Yes **X** No

5 TYPE OF BLANK CASING USED:

5 Wrought Iron

8 Concrete tile

CASING JOINTS: Glued \_\_\_\_\_ Clamped \_\_\_\_\_

1 Steel

3 RMP (SR)

6 Asbestos-Cement

9 Other (specify below)

Welded \_\_\_\_\_

2 PVC

4 ABS

7 Fiberglass

**Eagle - Loc**

Threaded \_\_\_\_\_

Blank casing diameter **5** in. to \_\_\_\_\_ ft., Dia \_\_\_\_\_ in. to \_\_\_\_\_ ft., Dia \_\_\_\_\_ in. to \_\_\_\_\_ ft.Casing height above land surface **24** in., weight \_\_\_\_\_ lbs./ft. Wall thickness or gauge No. **SDR21**

TYPE OF SCREEN OR PERFORATION MATERIAL:

1 Steel

3 Stainless steel

5 Fiberglass

7 PVC

10 Asbestos-cement

2 Brass

4 Galvanized steel

6 Concrete tile

8 RMP (SR)

11 Other (specify)

12 None used (open hole)

SCREEN OR PERFORATION OPENINGS ARE:

1 Continuous slot

3 Mill slot

5 Gauzed wrapped

8 Saw cut

11 None (open hole)

2 Louvered shutter

4 Key punched

6 Wire wrapped

9 Drilled holes

7 Torch cut

10 Other (specify)

SCREEN-PERFORATED INTERVALS: From **353** ft. to **373** ft. From **393** ft. to **413** ft.From **433** ft. to **453** ft. From \_\_\_\_\_ ft. to \_\_\_\_\_ ft.GRAVEL PACK INTERVALS: From **25** ft. to **453** ft. From \_\_\_\_\_ ft. to \_\_\_\_\_ ft.

From \_\_\_\_\_ ft. to \_\_\_\_\_ ft. From \_\_\_\_\_ ft. to \_\_\_\_\_ ft.

6 GROUT MATERIAL:

1 Neat cement

2 Cement grout

3 Bentonite

4 Other \_\_\_\_\_

Grout Intervals From **5** ft. to **25** ft. From \_\_\_\_\_ ft. to \_\_\_\_\_ ft. From \_\_\_\_\_ ft. to \_\_\_\_\_ ft.

What is the nearest source of possible contamination:

1 Septic tank

4 Lateral lines

7 Pit privy

10 Livestock pens

14 Abandoned water well

2 Sewer lines

5 Cess pool

8 Sewage lagoon

11 Fuel storage

15 Oil well/ Gas well

3 Watertight sewer lines

6 Seepage pit

9 Feedyard

12 Fertilizer storage

16 Other (specify below)

13 Insecticide storage

**None observed**

Direction from well?

How many feet?

FROM	TO	CODE	LITHOLOGIC LOG	FROM	TO	PLUGGING INTERVALS
0	40		Fine sand & sandy clay	434	450	Sandy clay & a little sand
40	78		Brown sandy clay	450	460	Brown clay
78	100		Caliche & sandy clay			
100	140		Fine to med sand & grvl; lit clay			
140	160		Brown clay			
160	170		Sand, med			
170	220		Sandy clay			
220	240		Fine to med sand & clay streaks			
240	260		Brown sandy clay			
260	300		Fine sand & clay mix			
300	370		Fine to med sand & a little clay			
370	380		Brown clay			
380	403		Sandy clay & a little sand			
403	434		Fine to med sand; some clay			

7 CONTRACTOR'S OR LANDOWNER'S CERTIFICATION: This water well was (1) constructed, (2) reconstructed, or (3) plugged under my jurisdiction and was constructed

completed on (mo/day/yr) **11/10/05**

and this record is true to the best of my knowledge and belief. Kansas

Water Well Contractor's License No. **473**This Water Well Record was completed on (mo/day/yr) **11/10/05**

under the business name of

**Tyler Water Well Service Inc**

by (signature)

INSTRUCTIONS: Please fill in blanks and circle the correct answers. Send three copies to Kansas Department of Health and Environment, Bureau of Water, Topeka, Kansas 66620-0001. Telephone: 913-296-5545. Send one to WATER WELL OWNER and retain one for your records.