

CORRECTION(S) TO WATER WELL RECORD (WWC-5)

(to rectify lacking or incorrect information)

County: Stevens

Location listed as:

Section-Township-Range: 13-34S-38WFraction ($\frac{1}{4}$ $\frac{1}{4}$ $\frac{1}{4}$): SW SE SW

Location changed to:

13-34S-39WSW SE SW

Other changes: Initial statements: _____

Changed to: _____

Comments: _____

verification method: Written & legal descriptions, county ownership map,
WMA's water rights record on KGS website, and mapping tool
& aerial photos on KGS website. initials: DRL date: 11/11/2009

submitted by: Kansas Geological Survey, Data Resources Library, 1930 Constant Ave., Lawrence, KS 66047-3726
to: Kansas Dept of Health & Environment, Bureau of Water, 1000 SW Jackson, Suite 420, Topeka, KS 66612-1367.

1 LOCATION OF WATER WELL:	Fraction	Section Number	Township Number	Range Number
County: <u>Stevens</u>	SW 1/4 SE 1/4 SW 1/4	13	T 34 S	R 38 <input checked="" type="checkbox"/> W

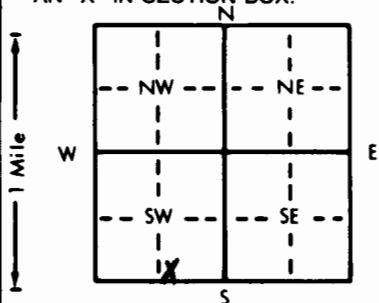
Distance and direction from nearest town or city street address of well if located within city?

5S 1/2W from Feteriea2 WATER WELL OWNER: Vincent YoungrenRR#, St. Address, Box # : P.O. Box 488

Board of Agriculture, Division of Water Resources

City, State, ZIP Code : Hugoton, KS 67951Application Number: 40,469

3 LOCATE WELL'S LOCATION WITH AN "X" IN SECTION BOX:

4 DEPTH OF COMPLETED WELL: ft. ELEVATION: 3000Depth(s) Groundwater Encountered 1. 200 ft. 2. ft. 3. ft.WELL'S STATIC WATER LEVEL 200 ft. below land surface measured on mo/day/yrPump test data: Well water was 230 ft. after 1 hours pumping 600 gpmEst. Yield 1800 gpm: Well water was 278 ft. after 1 hours pumping 1200 gpmBore Hole Diameter 26 in. to 415 ft., and in. to ft.

WELL WATER TO BE USED AS:

1 Domestic	3 Feedlot	6 Oil field water supply	9 Dewatering	12 Other (Specify below)
<u>2 Irrigation</u>	4 Industrial	7 Lawn and garden only	10 Monitoring well	

Was a chemical/bacteriological sample submitted to Department? Yes.....No.....☒; If yes, mo/day/yr sample was submittedWater Well Disinfected? Yes ☒ No

5 TYPE OF BLANK CASING USED:

1 Steel	3 RMP (SR)
<u>2 PVC</u>	4 ABS

5 Wrought iron

8 Concrete tile

CASING JOINTS: Glued ☒ Clamped

6 Asbestos-Cement

9 Other (specify below)

Welded

7 Fiberglass

Threaded

Blank casing diameter 16 in. to ft., Dia in. to ft., Dia in. to ft.Casing height above land surface 12 in., weight lbs./ft. Wall thickness or gauge No. SDR26 ft.

TYPE OF SCREEN OR PERFORATION MATERIAL:

1 Steel	3 Stainless steel
2 Brass	4 Galvanized steel

5 Fiberglass

7 PVC

10 Asbestos-cement

6 Concrete tile

8 RMP (SR)

11 Other (specify)

9 ABS

12 None used (open hole)

SCREEN OR PERFORATION OPENINGS ARE:

1 Continuous slot	<u>3 Mill slot</u>
2 Louvered shutter	4 Key punched

5 Gauzed wrapped

8 Saw cut

11 None (open hole)

6 Wire wrapped

9 Drilled holes

7 Torch cut

10 Other (specify)

SCREEN-PERFORATED INTERVALS: From 275 ft. to 355 ft., From 395 ft. to 415 ft.

From ft. to ft., From ft. to ft.

GRAVEL PACK INTERVALS: From 20 ft. to 415 ft., From ft. to ft.

From ft. to ft., From ft. to ft.

6 GROUT MATERIAL:

1 Neat cement

2 Cement grout

3 Bentonite

4 Other

Grout intervals: From 0 ft. to 20 ft., From ft. to ft., From ft. to ft.

What is the nearest source of possible contamination:

1 Septic tank

4 Lateral lines

7 Pit privy

10 Livestock pens

14 Abandoned water well

2 Sewer lines

5 Cess pool

8 Sewage lagoon

11 Fuel storage

15 Oil well/Gas well

3 Watertight sewer lines

6 Seepage pit

9 Feedyard

12 Fertilizer storage

16 Other (specify below)

13 Insecticide storage

none in .1mi.

Direction from well?

How many feet?

FROM	TO	LITHOLOGIC LOG	FROM	TO	PLUGGING INTERVALS
0	7	Top soil	388	395	Fine to Medium Sand
7	37	Fine sand (loose)	395	415	Brown Clay
37	66	Brown sandy clay, White rock mix			
66	87	Brown Clay			
87	94	Fine sand			
94	101	Brown sandy clay			
101	113	Fine sand 10% clay			
113	130	Fine to Medium Sand			
130	272	Brown Sandy Clay & White rock			
272	305	Fine Sand & 10% Clay			
305	330	Fine to Medium Sand			
330	337	Brown Sandy Clay			
337	366	Fine Sand 10% Clay			
366	388	Brown Sandy Clay			

7 CONTRACTOR'S OR LANDOWNER'S CERTIFICATION: This water well was (1) constructed, (2) reconstructed, or (3) plugged under my jurisdiction and was completed on (mo/day/year) May 24, 1994 and this record is true to the best of my knowledge and belief. KansasWater Well Contractor's License No. 473 This Water Well Record was completed on (mo/day/yr) May 24, 1994under the business name of Tyler Water Wellby (signature) [Signature]