


1 LOCATION OF WATER WELL:		Fraction		Section Number		Township Number		Range Number	
County:	Stevens	SW 1/4 SW 1/4 NW 1/4	3	T 34 S	R 39 E/W				

Distance and direction from nearest town or city street address of well if located within city?

3 West. $1\frac{1}{2}$ South & $5/8$ of a Mile West of Feterita, Kansas

2	WATER WELL OWNER:	Claude Davis	
	RR#, St. Address, Box # :	HC-01 - Box 1B	Board of Agriculture, Division of Water Resources
	City, State, ZIP Code :	Hugoton, Kansas 67951	Application Number:

3	LOCATE WELL'S LOCATION WITH AN "X" IN SECTION BOX:	4	DEPTH OF COMPLETED WELL.....168..... ft. ELEVATION:
---	--	---	---

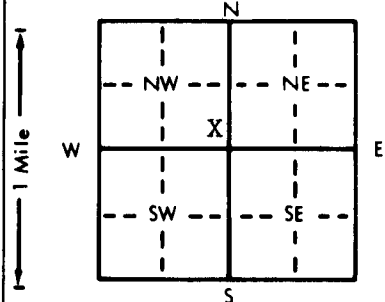

4. DEPTH OF COMPLETED WELL. 168 ft. ELEVATION:

Depth(s) Groundwater Encountered 1. ft. 2. ft. 3. ft.

WELL'S STATIC WATER LEVEL . . 110 ft. below land surface measured on mo/day/yr 3-4-86

Pump test data: Well water was ft. after hours pumping gpm

Est. Yield . . 20 . . gpm: Well water was ft. after hours pumping gpm

Bore Hole Diameter. 10-3/4in. to . . 168 ft., and in. to ft.

WELL WATER TO BE USED AS:

1 Domestic	3 Feedlot	6 Oil field water supply	9 Dewatering	11 Injection well
2 Irrigation	4 Industrial	7 Lawn and garden only	10 Observation well	12 Other (Specify below) Stock Well

Was a chemical/bacteriological sample submitted to Department? Yes No X; If yes, mo/day/yr sample was submitted

Water Well Disinfected? Yes X No

5 TYPE OF BLANK CASING USED:		5 Wrought iron	8 Concrete tile	CASING JOINTS: Glued . . . <input checked="" type="checkbox"/> . . . Clamped
1 Steel	3 RMP (SR)	6 Asbestos-Cement	9 Other (specify below)	Welded
2 PVC	4 ABS	7 Fiberglass		Threaded

Blank casing diameter . . . 5 . . . in. to . . . 168 . . . ft., Dia . . . in. to . . . ft., Dia . . . in. to . . . ft.
Casing height above land surface . . . 18 . . . in., weight . . . 2.84 . . . lbs./ft. Wall thickness or gauge No. . . 265

TYPE OF SCREEN OR PERFORATION MATERIAL:					
1 Steel	3 Stainless steel	5 Fiberglass	7 PVC	10 Asbestos-cement	
2 Brass	4 Galvanized steel	6 Concrete tile	8 RMP (SR)	11 Other (specify)	
			9 ABS	12 None used (open hole)	

SCREEN OR PERFORATION OPENINGS ARE:

1 Continuous slot	3 Mill slot	5 Gauzed wrapped	8 Saw cut	11 None (open hole)
2 Louvered shutter	4 Key punched	6 Wire wrapped	9 Drilled holes	
		7 Torch cut	10 Other (specify)	

SCREEN-PERFORATED INTERVALS:	From 118 ft. to 168 ft.,	From ft. to ft.
	From ft. to ft.,	From ft. to ft.
GRAVEL PACK INTERVALS:	From 25 ft. to 168 ft.,	From ft. to ft.
	From ft. to ft.,	From ft. to ft.

6 GROUT MATERIAL: ① Neat cement 2 Cement grout ③ Bentonite 4 Other
Grout Intervals: From 5 ft. to 20 ft. From 20 ft. to 25 ft. From ft. to ft.

What is the nearest source of possible contamination:

1 Septic tank	4 Lateral lines	7 Pit privy	10 Livestock pens	14 Abandoned water well
2 Sewer lines	5 Cess pool	8 Sewage lagoon	11 Fuel storage	15 Oil well/Gas well
3 Watertight sewer lines	6 Seepage pit	9 Feedyard	12 Fertilizer storage	16 Other (specify below)
			13 Insecticide storage	

Direction from well?	How many feet?	500
----------------------	----------------	-----

[illegible]

7 CONTRACTOR'S OR LANDOWNER'S CERTIFICATION: This water well was (1) constructed, (2) reconstructed, or (3) plugged under my jurisdiction and was completed on (mo/day/year) 3-4-86 and this record is true to the best of my knowledge and belief. Kansas Water Well Contractor's License No. 208 This Water Well Record was completed on (mo/day/yr) 3-18-86 under the business name of Minter-Wilson Drilling Co., Inc. by (signature) Nora Keller

INSTRUCTIONS: Use typewriter or ball point pen, PLEASE PRESS FIRMLY and PRINT clearly. Please fill in blanks, underline or circle the correct answers. Send top three copies to Kansas Department of Health and Environment, Division of Environment, Environmental Geology Section, Topeka, KS 66620. Send one to WATER WELL OWNER and retain one for your records.

The
Professionals

MINTER-WILSON DRILLING CO.

INCORPORATED

Irrigation
and Domestic
Water Systems
Complete Installation
and Repairing

Phone 276-8269 • P.O. Box A • GARDEN CITY, KANSAS 67846

Claude Davis
Stevens County
3-3-86

Location: NW $\frac{1}{4}$ 3-34-39
From Feterita - 3 Miles West, 1 $\frac{1}{2}$ Miles
South, $\frac{1}{2}$ Mile West - About 400 ft.
West of Gas House

Static Water Level: 110

Test #1

0	5	Top soil, fine sand
5	7	Brown clay
7	53	Fine sand
53	84	Fine to medium sand - tight
84	117	Brown sandy clay - hard
117	127	Brown sandy clay - 15% gravel
127	141	Fine to medium sand
141	146	Brown sandy clay
146	160	Fine to medium sand, small brown rock 20% clay - tight
160	164	Fine to medium sand - small brown rock loose
164	170	Brown clay

Supply Well
Well - 168'
5 inch plastic casing
10-5/8" hole
118 Plain
50 Perf.
2 Yards gravel