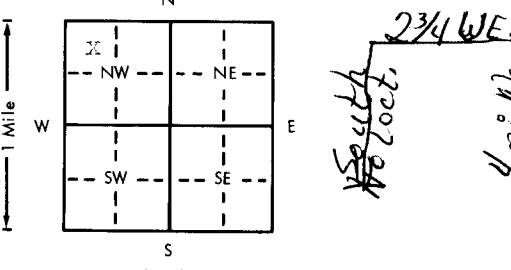


USE TYPEWRITER OR BALL
POINT PEN-PRESS FIRMLY,
PRINT CLEARLY.

WATER WELL RECORD
KSA 82a-1201-1215

Kansas Department of Health and
Environment-Division of Environment
(Water well Contractors)
Topeka, Kansas 66620

CWW Inv. #13597

1. Location of well:		County Stevens	Fraction 1/4 NW 1/4 NW 1/4	Section number 14	Township number T 34S	Range number S 39W E/W
2. Distance and direction from nearest town or city: Go West of Liberal on 2nd St. Rd. to 3rd stop sign - then 4 mi North - 2 3/4 mi. West - South into loc.		3. Owner of well: Anadarko Production Co.		P. O. Box 351 - Paul Gatlin City, state, zip code: Liberal, Kansas 67901		
4. Locate with "X" in section below:		Sketch map:		6. Bore hole dia. 9 in. Completion date 6/28/77 Well depth 280 ft.		
				7. <input checked="" type="checkbox"/> Cable tool <input checked="" type="checkbox"/> Rotary <input type="checkbox"/> Driven <input type="checkbox"/> Dug <input type="checkbox"/> Hollow rod <input type="checkbox"/> Jetted <input type="checkbox"/> Bored <input type="checkbox"/> Reverse rotary		
5. Type and color of material		From		To		8. Use: <input type="checkbox"/> Domestic <input type="checkbox"/> Public supply <input checked="" type="checkbox"/> Industry <input type="checkbox"/> Irrigation <input type="checkbox"/> Air conditioning <input type="checkbox"/> Stock <input type="checkbox"/> Lawn <input checked="" type="checkbox"/> Oil field water <input type="checkbox"/> Other
Surface		0		2		9. Casing: Material <input type="checkbox"/> Height: Above or below Threaded <input type="checkbox"/> Welded <input type="checkbox"/> Surface 28 in. RMP <input type="checkbox"/> PVC <input checked="" type="checkbox"/> Weight 2.78 lbs./ft. Dia. 5 in. to 175 ft. depth Wall Thickness: inches or Dia. 5 in. to 280 ft. depth gage No. 265
Fine sand		2		120		10. Screen: Manufacturer's name Sawed perf. Type PVC Dia. 5" Slot/gauze .030 Length 100' Set between 175 ft. and 275 ft. Set between 175 ft. and 275 ft. Gravel pack? yes Size range of material 1/8-3/16
Sandy clay		120		165		11. Static water level: 175 ft. below land surface Date 6/28/77 mo./day/yr.
Clay and fine sand		165		280		12. Pumping level below land surfaces: ____ ft. after ____ hrs. pumping ____ g.p.m. ____ ft. after ____ hrs. pumping ____ g.p.m. Estimated maximum yield 40 g.p.m.
						13. Water sample submitted: ____ mo./day/yr. Yes <input checked="" type="checkbox"/> No <input type="checkbox"/> Date ____
						14. Well head completion: ____ Pitless adapter 28 Inches above grade
						15. Well grouted? yes With: <input checked="" type="checkbox"/> Neat cement <input type="checkbox"/> Bentonite <input type="checkbox"/> Concrete Depth: From 0 ft. to 10 ft.
						16. Nearest source of possible contamination: ft. 100 Direction NE Type oil well Well disinfected upon completion? <input checked="" type="checkbox"/> Yes <input type="checkbox"/> No
						17. Pump: <input checked="" type="checkbox"/> Not installed Manufacturer's name ____ Model number ____ HP ____ Volts ____ Length of drop pipe ____ ft. capacity ____ g.p.m. Type: ____ Submersible ____ Turbine ____ Jet ____ Reciprocating ____ Centrifugal ____ Other
						20. Water well contractor's certification: This well was drilled under my jurisdiction and this report is true to the best of my knowledge and belief. Carlile Water Well Service 118 Business name Box 275, Liberal, KS License No. ____ Address Box 275, Liberal, KS Signed Edward E. Means Date 7/12/77 Authorized representative
18. Elevation:		19. Remarks:				
Topography: ____ Hill ____ Slope <input checked="" type="checkbox"/> Upland ____ Valley						

34 39W 14 NW 1/4

Sec 14 NW 1/4