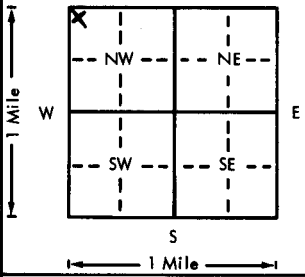


USE TYPEWRITER OR BALL  
POINT PEN-PRESS FIRMLY,  
PRINT CLEARLY.

WATER WELL RECORD  
KSA 82a-1201-1215

Kansas Department of Health and  
Environment-Division of Environment  
(Water well Contractors)  
Topeka, Kansas 66620

1. Location of well:		County <u>Stevens</u>	Fraction <u>NW 1/4 NW 1/4 NW 1/4</u>	Section number <u>27</u>	Township number <u>T 34</u>	Range number <u>S R 39 E/W</u>	
X Distance and direction from nearest town or city: <u>7.5 mi. 4 W of Feterita</u>		3. Owner of well: <u>Bill Bressler</u> R.R. or street: <u>Rt. 1</u> City, state, zip code: <u>Guymon, Oklahoma 73942</u>					
4. Locate with "X" in section below: 		Sketch map:		6. Bore hole dia. <u>9</u> in. Completion date <u>4/1/76</u> Well depth <u>300</u> ft.			
5. Type and color of material		From		To		7. <input type="checkbox"/> Cable tool <input checked="" type="checkbox"/> Rotary <input type="checkbox"/> Driven <input type="checkbox"/> Dug <input type="checkbox"/> Hollow rod <input type="checkbox"/> Jetted <input type="checkbox"/> Bored <input type="checkbox"/> Reverse rotary	
						8. Use: <input checked="" type="checkbox"/> Domestic <input type="checkbox"/> Public supply <input type="checkbox"/> Industry <input type="checkbox"/> Irrigation <input type="checkbox"/> Air conditioning <input type="checkbox"/> Stock <input type="checkbox"/> Lawn <input type="checkbox"/> Oil field water <input type="checkbox"/> Other	
						9. Casing: Material <u>PTS</u> Height: <u>Above</u> or below Threaded <input type="checkbox"/> Welded <u>5/8</u> Surface <u>14</u> in. RMP <input type="checkbox"/> PVC <input checked="" type="checkbox"/> Weight <u>15</u> lbs./ft. Dia. <u>5</u> in. to <u>240</u> ft. depth Wall Thickness: inches or Dia. <u>5</u> in. to <u>240</u> ft. depth Gauge No. <u>0-320</u>	
						10. Screen: Manufacturer's name <u>J &amp; L</u> Type <u>PVC</u> Dia. <u>5"</u> Slot/gauze <u>1/16</u> Length <u>60</u> Set between <u>240</u> ft. and <u>300</u> ft. Gravel pack? <u>Yes</u> Size range of material <u>4R"</u>	
						11. Static water level: <u>162</u> ft. below land surface Date <u>4/1/76</u> mo./day/yr.	
(Use a second sheet if needed)						12. Pumping level below land surfaces: ____ ft. after ____ hrs. pumping ____ g.p.m. ____ ft. after ____ hrs. pumping ____ g.p.m. Estimated maximum yield <u>30</u> g.p.m.	
						13. Water sample submitted: ____ mo./day/yr. Yes <input checked="" type="checkbox"/> No <input type="checkbox"/> Date ____	
						14. Well head completion: ____ Pitless adapter <u>14</u> inches above grade	
						15. Well grouted? <u>Yes</u> With: <input checked="" type="checkbox"/> Neat cement <input type="checkbox"/> Bentonite <input type="checkbox"/> Concrete Depth: From <u>3</u> ft. to <u>13</u> ft.	
						16. Nearest source of possible contamination: ft. ____ Direction ____ Type ____ Well disinfected upon completion? <input checked="" type="checkbox"/> Yes <input type="checkbox"/> No	
18. Elevation:		19. Remarks: <u>#16 Pasture Well</u> <u>Well to be completed by:</u> <u>Ritter Well Service</u> <u>Guymon, Oklahoma</u>		20. Water well contractor's certification: This well was drilled under my jurisdiction and this report is true to the best of my knowledge and belief. <u>T &amp; W Water Well</u> <u>142</u> Business name License No. Address <u>Box 816 Liberal, KS</u> Signed <u>C. W. Wynn</u> Date <u>5/10/76</u> Authorized representative			
						17. Pump: <input checked="" type="checkbox"/> Not installed Manufacturer's name ____ Model number ____ HP ____ Volts ____ Length of drop pipe ____ ft. capacity ____ g.p.m. Type: <input type="checkbox"/> Submersible <input type="checkbox"/> Turbine <input type="checkbox"/> Jet <input type="checkbox"/> Reciprocating <input type="checkbox"/> Centrifugal <input type="checkbox"/> Other	
						18. Elevation:	
						19. Remarks:	
						20. Water well contractor's certification:	

T  
R  
E  
S  
E  
C  
1/4  
1/4  
1/4