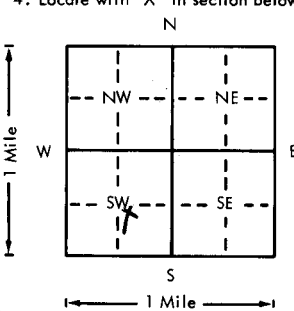


USE TYPEWRITER OR BALL
POINT PEN-PRESS FIRMLY,
PRINT CLEARLY.

WATER WELL RECORD
KSA 82a-1201-1215

Kansas Department of Health and
Environment-Division of Environment
(Water well Contractors)
Topeka, Kansas 66620

1. Location of well:		County STEVENS	Fraction NW 1/4 SE 1/4 SW 1/4	Section number 34	Township number T 34 S R 39 E/W	Range number
2. Distance and direction from nearest town or city: 8 3/4 South of Hucobu Kn		3. Owner of well: WRIGHT, LOWERY & WILLIAMS		R.R. or street: Box 549		
Street address of well location if in city:		City, state, zip code: Woodward, OK 73801		Completion date 11-13-78		
4. Locate with "X" in section below:		Sketch map:		6. Bore hole dia. 2 1/2 in. Well depth 522 ft.		
				7. <input checked="" type="checkbox"/> Cable tool <input checked="" type="checkbox"/> Rotary <input type="checkbox"/> Driven <input type="checkbox"/> Dug <input type="checkbox"/> Hollow rod <input type="checkbox"/> Jetted <input type="checkbox"/> Bored <input type="checkbox"/> Reverse rotary		
5. Type and color of material		From	To	8. Use: <input type="checkbox"/> Domestic <input type="checkbox"/> Public supply <input type="checkbox"/> Industry <input checked="" type="checkbox"/> Irrigation <input type="checkbox"/> Air conditioning <input type="checkbox"/> Stock <input type="checkbox"/> Lawn <input type="checkbox"/> Oil field water <input type="checkbox"/> Other		
Overburden		0	180	9. Casing: Material Steel Height: Above or below Threaded <input type="checkbox"/> Welded <input checked="" type="checkbox"/> Surface 12 in. RMP <input type="checkbox"/> PVC <input type="checkbox"/> Weight 42.5 lbs./ft.		
Fine Sand & clay		180	200	Dia. 16 in. to 522 ft. depth Wall Thickness: inches or Dia. <input type="checkbox"/> in. to <input type="checkbox"/> ft. depth gage No. 250		
Med to coarse sand & clay		200	240	10. Screen: Manufacturer's name Johnson		
Fine sand & clay		240	340	Type Steel Dia. 16 Slot/gauze 1/8 Length 5 ft.		
Clay		340	380	Set between 420 ft. and 440 ft.		
Med sand w/clay		380	400	480 ft. and 500 ft.		
Med sand & clay		400	480	Gravel pack? <input checked="" type="checkbox"/> Size range of material 1/8-1/4		
Coarse sand		480	500	11. Static water level: 182 ft. below land surface Date 11-17-78		
Med sand and clay		500	520	12. Pumping level below land surfaces: NA		
Fine sand & clay		520	538	____ ft. after ____ hrs. pumping ____ g.p.m.		
				____ ft. after ____ hrs. pumping ____ g.p.m.		
				Estimated maximum yield ____ g.p.m.		
				13. Water sample submitted: ____ mo./day/yr.		
				Yes <input checked="" type="checkbox"/> No <input type="checkbox"/> Date ____		
				14. Well head completion: ____ Pitless adapter ____ Inches above grade		
				15. Well grouted? <input checked="" type="checkbox"/> With: <input checked="" type="checkbox"/> Neat cement <input type="checkbox"/> Bentonite <input type="checkbox"/> Concrete		
				Depth: From 0 ft. to 10 ft.		
				16. Nearest source of possible contamination: ____ ft. ____ Direction ____ Type ____		
				Well disinfected upon completion? ____ Yes <input checked="" type="checkbox"/> No <input type="checkbox"/>		
				17. Pump: <input checked="" type="checkbox"/> Not installed		
				Manufacturer's name ____		
				Model number ____ HP ____ Volts ____		
				Length of drop pipe ____ ft. capacity ____ g.p.m.		
				Type: ____ Submersible ____ Turbine		
				____ Jet ____ Reciprocating		
				____ Centrifugal ____ Other		
18. Elevation:		19. Remarks:		20. Water well contractor's certification:		
Topography: ____ Hill ____ Slope <input checked="" type="checkbox"/> Upland ____ Valley		Perf. 222-420 440-480 500-522 16. Cropland		This well was drilled under my jurisdiction and this report is true to the best of my knowledge and belief. 225 KTM DRILLING, INC. Business name Box 1385, Seymour, OK License No. ____ Address ____ Signed [Signature] Date 1/22/79 Authorized representative		