


1 LOCATION OF WATER WELL: Fraction NW 1/4 NE 1/4 NW 1/4 Section Number 35 Township Number T 34 S Range Number R 39 EW

Distance and direction from nearest town or city street address of well if located within city?
 7 1/2 miles South 1 1/2 West of Feterita, Ks.

2 WATER WELL OWNER: Hayword M-1 Gabbert & Jones
 RR#, St. Address, Box #: 333 E. English Board of Agriculture, Division of Water Resources
 City, State, ZIP Code: Wichita, Ks. 67202 Application Number: T87-229

3 LOCATE WELL'S LOCATION WITH AN "X" IN SECTION BOX:

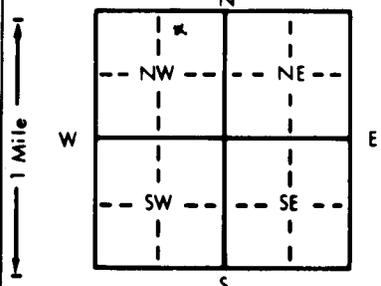

4 DEPTH OF COMPLETED WELL... 320 ft. ELEVATION: ...

Depth(s) Groundwater Encountered 1. 145 ft. 2. ft. 3. ft.
 WELL'S STATIC WATER LEVEL... 175 ft. below land surface measured on mo/day/yr 6-14-87
 Pump test data: Well water was 190 ft. after 2 hours pumping 55 gpm
 Est. Yield... 60 gpm: Well water was ft. after hours pumping gpm
 Bore Hole Diameter... 9 in. to 320 ft., and in. to ft.
 WELL WATER TO BE USED AS: 5 Public water supply 8 Air conditioning 11 Injection well
 1 Domestic 3 Feedlot 6 Oil field water supply 9 Dewatering 12 Other (Specify below)
 2 Irrigation 4 Industrial 7 Lawn and garden only 10 Observation well
 Was a chemical/bacteriological sample submitted to Department? Yes... No... X...; If yes, mo/day/yr sample was submitted Water Well Disinfected? Yes X No

5 TYPE OF BLANK CASING USED: 5 Wrought iron 8 Concrete tile CASING JOINTS: Glued X Clamped
 1 Steel 3 RMP (SR) 6 Asbestos-Cement 9 Other (specify below) Welded
 2 PVC 4 ABS 7 Fiberglass Threaded

Blank casing diameter... 5 in. to 240 ft., Dia... in. to ft., Dia... in. to ft.
 Casing height above land surface... 14 in., weight... 200 lbs./ft. Wall thickness or gauge No. 0.265

TYPE OF SCREEN OR PERFORATION MATERIAL: 7 PVC 10 Asbestos-cement
 1 Steel 3 Stainless steel 5 Fiberglass 8 RMP (SR) 11 Other (specify)
 2 Brass 4 Galvanized steel 6 Concrete tile 9 ABS 12 None used (open hole)

SCREEN OR PERFORATION OPENINGS ARE: 5 Gauzed wrapped 8 Saw cut 11 None (open hole)
 1 Continuous slot 3 Mill slot 6 Wire wrapped 9 Drilled holes
 2 Louvered shutter 4 Key punched 7 Torch cut 10 Other (specify)

SCREEN-PERFORATED INTERVALS: From 175 ft. to 320 ft., From ft. to ft.
 GRAVEL PACK INTERVALS: From 160 ft. to 320 ft., From ft. to ft.

6 GROUT MATERIAL: 1 Neat cement 2 Cement grout 3 Bentonite 4 Other
 Grout Intervals: From 0 ft. to 15 ft., From ft. to ft., From ft. to ft.

What is the nearest source of possible contamination: 10 Livestock pens 14 Abandoned water well
 1 Septic tank 4 Lateral lines 7 Pit privy 11 Fuel storage 15 Oil well/Gas well
 2 Sewer lines 5 Cess pool 8 Sewage lagoon 12 Fertilizer storage 16 Other (specify below)
 3 Watertight sewer lines 6 Seepage pit 9 Feedyard 13 Insecticide storage
 Direction from well? Southwest How many feet? 300

FROM	TO	LITHOLOGIC LOG	FROM	TO	LITHOLOGIC LOG
0	175	Overburden			
175	200	Clay			
200	220	Fine sand and clay			
220	240	Fine sand and clay			
240	260	Fine sand and clay			
260	280	Fine sand and clay			
280	300	Fine sand and clay			
300	320	Fine sand and clay			

7 CONTRACTOR'S OR LANDOWNER'S CERTIFICATION: This water well was (1) constructed, (2) reconstructed, or (3) plugged under my jurisdiction and was completed on (mo/day/year) 6-14-87 and this record is true to the best of my knowledge and belief. Kansas Water Well Contractor's License No. 142 This Water Well Record was completed on (mo/day/yr) 6-25-87 under the business name of T & W Water Well Service, Inc by (signature) CD Wagner

OFFICE USE ONLY
T 34 S
R 39
EW
35 NW 1/4 NE 1/4 NW 1/4