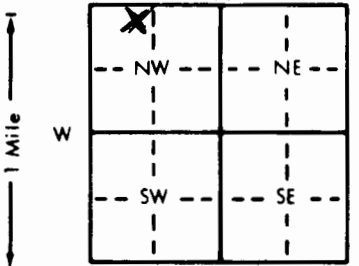


1 LOCATION OF WATER WELL:	Fraction	Section Number	Township Number	Range Number
County: MORTON	NE ¼ NW ¼ NW ¼	33	T 34 S	R 40 EW

Distance and direction from nearest town or city street address of well if located within city?

JCT SOUTH OF ROLLA: 2 WEST, 1 NORTH, WEST 1 3/4.

2 WATER WELL OWNER: SEABOARD FARM CO.	WELL # 3
RR#, St. Address, Box #: P.O. BOX 1209	Board of Agriculture, Division of Water Resources
City, State, ZIP Code: GYMON, OK 73942	Application Number:

3 LOCATE WELL'S LOCATION WITH AN "X" IN SECTION BOX:	4 DEPTH OF COMPLETED WELL: 360 ft. ELEVATION:
	Depth(s) Groundwater Encountered 1. 160 ft. 2. ft. 3. ft.
	WELL'S STATIC WATER LEVEL 160 ft. below land surface measured on mo/day/yr 02-13-96
	Pump test data: Well water was 180 ft. after 1 hours pumping 100 gpm
	Est. Yield 100 gpm: Well water was ft. after hours pumping gpm
	Bore Hole Diameter 11 in. to 360 ft. and in. to ft.
	WELL WATER TO BE USED AS:
	1 Domestic 3 Feedlot 6 Oil field water supply 9 Dewatering 11 Injection well
	2 Irrigation 4 Industrial 7 Lawn and garden only 10 Monitoring well 12 Other (Specify below)
	Was a chemical/bacteriological sample submitted to Department? Yes No X If yes, mo/day/yr sample was submitted
	Water Well Disinfected? Yes X No

5 TYPE OF BLANK CASING USED:	5 Wrought iron 8 Concrete tile CASING JOINTS: Glued X Clamped
1 Steel 3 RMP (SR)	6 Asbestos-Cement 9 Other (specify below) Welded
2 PVC 4 ABS	7 Fiberglass Threaded
Blank casing diameter 6 in. to 360 ft. Dia	in. to ft. Dia in. to ft.
Casing height above land surface 24 in. weight 2.902 lbs./ft. Wall thickness or gauge No. .280 SDR 21	
TYPE OF SCREEN OR PERFORATION MATERIAL:	
1 Steel 3 Stainless steel 5 Fiberglass 8 RMP (SR) 10 Asbestos-cement	
2 Brass 4 Galvanized steel 6 Concrete tile 9 ABS 11 Other (specify)	
SCREEN OR PERFORATION OPENINGS ARE:	
1 Continuous slot 3 Mill slot 5 Gauzed wrapped 8 Saw cut 11 None (open hole)	
2 Louvered shutter 4 Key punched 6 Wire wrapped 9 Drilled holes	
7 Torch cut 10 Other (specify)	
SCREEN-PERFORATED INTERVALS: From 300 ft. to 360 ft. From ft. to ft.	
GRAVEL PACK INTERVALS: From 200 ft. to 360 ft. From ft. to ft.	

6 GROUT MATERIAL:	1 Neat cement 2 Cement grout 3 Bentonite 4 Other HOLE PLUG
Grout Intervals: From 0 ft. to 16 ft. From ft. to ft.	
What is the nearest source of possible contamination:	
1 Septic tank 4 Lateral lines 7 Pit privy 11 Fuel storage 14 Abandoned water well	
2 Sewer lines 5 Cess pool 8 Sewage lagoon 12 Fertilizer storage 15 Oil well/Gas well	
3 Watertight sewer lines 6 Seepage pit 9 Feedyard 13 Insecticide storage 16 Other (specify below)	
Direction from well?	How many feet?

FROM	TO	LITHOLOGIC LOG	FROM	TO	PLUGGING INTERVALS
0	2	SAND	238	244	CLAY
2	9	SAND	244	250	SAND
9	49	CLAY & SANDY CLAY	250	260	SANDY CLAY
49	64	SAND	260	270	SAND
64	100	CLAY & SANDY CLAY	270	280	SAND & SANDY CLAY
100	116	COARSE SAND	280	328	COARSE SAND
116	124	SANDY CLAY	328	351	SAND
124	140	COARSE SAND & CLAY STREAKS	351	360	RED
140	152	SAND & SANDY CLAY			
152	163	CLAY			
163	180	SANDY CLAY			
180	198	CLAY & SANDY CLAY			
198	212	SAND			
212	220	SAND & SANDY CLAY			
220	238	COARSE SAND			

7 CONTRACTOR'S OR LANDOWNER'S CERTIFICATION: This water well was (1) constructed, (2) reconstructed, or (3) plugged under my jurisdiction and was completed on (mo/day/year) 02-13-96 and this record is true to the best of my knowledge and belief. Kansas Water Well Contractor's License No. KWCL-430 This Water Well Record was completed on (mo/day/yr) 02-13-96 under the business name of HOWARD DRUG CO. BOX 806 BEAVER, OK 73932 by (signature) <i>[Signature]</i>
