WATER WELL RECORD Form WWC-5 KSA 82a-1212

1 LOCATION OF WATER WELL: County: Morton | Fraction: SW ¼ SW ¼ SW ¼ | Section Number: 35 | Township Number: T 34 S | Range Number: R 40 E/W

Distance and direction from nearest town or city street address of well if located within city?
5 MILES SOUTH & 1 MILE WEST OF ROLLA, KANSAS.

2 WATER WELL OWNER: Wesley Bressler
RR#, St. Address, Box # : Rt. 1 Box 64
City, State, ZIP Code : Elkhart, Kansas 67950
Board of Agriculture, Division of Water Resources
Application Number: 41,853

3 LOCATE WELL'S LOCATION WITH AN "X" IN SECTION BOX:

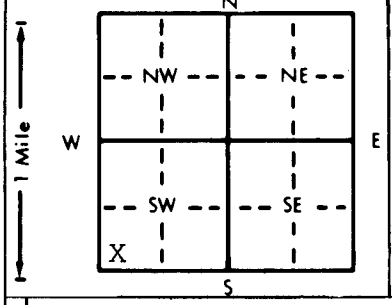

4 DEPTH OF COMPLETED WELL 458 ft. ELEVATION:
Depth(s) Groundwater Encountered 1. ft. 2. ft. 3. ft.
WELL'S STATIC WATER LEVEL 196 ft. below land surface measured on mo/day/yr 2-26-98
Pump test data: Well water was ft. after hours pumping gpm
Est. Yield gpm: Well water was ft. after hours pumping gpm
Bore Hole Diameter 26 in. to 458 ft., and in. to ft.
WELL WATER TO BE USED AS: 5 Public water supply 8 Air conditioning 11 Injection well
1 Domestic 3 Feedlot 6 Oil field water supply 9 Dewatering 12 Other (Specify below)
X Irrigation 4 Industrial 7 Lawn and garden only 10 Monitoring well
Was a chemical/bacteriological sample submitted to Department? Yes No X; If yes, mo/day/yr sample was submitted
Water Well Disinfected? Yes No

5 TYPE OF BLANK CASING USED: 5 Wrought iron 8 Concrete tile CASING JOINTS: Glued Clamped
X1 Steel 3 RMP (SR) 6 Asbestos-Cement 9 Other (specify below) Welded X
2 PVC 4 ABS 7 Fiberglass Threaded
Blank casing diameter 16 in. to 458 ft., Dia in. to ft., Dia in. to ft.
Casing height above land surface 12 in., weight 42.5 lbs./ft. Wall thickness or gauge No. .250

TYPE OF SCREEN OR PERFORATION MATERIAL: 7 PVC 10 Asbestos-cement
1X Steel 3 Stainless steel 5 Fiberglass 8 RMP (SR) 11 Other (specify)
2 Brass 4 Galvanized steel 6 Concrete tile 9 ABS 12 None used (open hole)

SCREEN OR PERFORATION OPENINGS ARE: 5 Gauzed wrapped 8 Saw cut 11 None (open hole)
1 Continuous slot X3 Mill slot 6 Wire wrapped 9 Drilled holes
2 Louvered shutter 4 Key punched 7 Torch cut 10 Other (specify)

SCREEN-PERFORATED INTERVALS: From 0 ft. to 0 ft., From 201 ft. to 458 ft.
From ft. to ft., From ft. to ft.
GRAVEL PACK INTERVALS: From 20 ft. to 458 ft., From ft. to ft.
From ft. to ft., From ft. to ft.

6 GROUT MATERIAL: X Neat cement 2 Cement grout 3 Bentonite 4 Other
Grout Intervals: From 0 ft. to 20 ft., From ft. to ft., From ft. to ft.

What is the nearest source of possible contamination:
1 Septic tank 4 Lateral lines 7 Pit privy 10 Livestock pens 14 Abandoned water well
2 Sewer lines 5 Cess pool 8 Sewage lagoon 11 Fuel storage 15 Oil well/Gas well
3 Watertight sewer lines 6 Seepage pit 9 Feedyard 12 Fertilizer storage 16X Other (specify below)
13 Insecticide storage Cropland-nothing
Direction from well? How many feet? immediate vicinity

FROM	TO	LITHOLOGIC LOG	FROM	TO	PLUGGING INTERVALS
0	217	Sticky clay, clay & sand mix			
217	247	Mostly clay w/some sand streaks			
247	277	Mostly clay			
277	308	Mostly clay, clay & sand mix			
308	337	Clay & med. sand			
337	368	Mostly clay w/some sand			
368	399	Mostly clay w/some sand			
399	430	Med. to coarse sand w/some clay streaks			
430	461	Coarse sand &pink clay , red bed			

7 CONTRACTOR'S OR LANDOWNER'S CERTIFICATION: This water well was (X) constructed, (2) reconstructed, or (3) plugged under my jurisdiction and was completed on (mo/day/year) 2-23-98 and this record is true to the best of my knowledge and belief. Kansas Water Well Contractor's License No. 225 This Water Well Record was completed on (mo/day/yr) 4-15-98 under the business name of KTM Drilling, Inc. by (signature)

INSTRUCTIONS: Use typewriter or ball point pen. *PLEASE PRESS FIRMLY* and *PRINT* clearly. Please fill in blanks, underline or circle the correct answers. Send top three copies to Kansas Department of Health and Environment, Bureau of Water, Topeka, Kansas 66620-0001. Telephone: 913-296-5545. Send one to WATER WELL OWNER and retain one for your records.

OFFICE USE ONLY T R E/W SEC. ¼ ¼ ¼