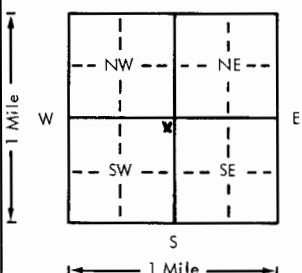


USE TYPEWRITER OR BALL
POINT PEN-PRESS FIRMLY,
PRINT CLEARLY.

WATER WELL RECORD
KSA 82a-1201-1215

Kansas Department of Health and
Environment-Division of Environment
(Water well Contractors)
Topeka, Kansas 66620

1. Location of well:		County Morton	Fraction NE 1/4 NE 1/4 SW 1/4	Section number 7	Township number T 34 S R 40 E/W	Range number	
2. Distance and direction from nearest town or city: 4 W 1 1/2 S 1/2 W. of Rolla, KS			3. Owner of well: U.S. Forest Service R.R. or street: City, state, zip code: Eikhart, KS 67950				
4. Locate with "X" in section below: N W E S 1 Mile		Sketch map: 		6. Bore hole dia. 9 in. Completion date 6/21/78 Well depth 260 ft.			
5. Type and color of material		From		To		7. <input type="checkbox"/> Cable tool <input checked="" type="checkbox"/> Rotary <input type="checkbox"/> Driven <input type="checkbox"/> Dug <input type="checkbox"/> Hollow rod <input type="checkbox"/> Jetted <input type="checkbox"/> Bored <input type="checkbox"/> Reverse rotary	
						8. Use: <input type="checkbox"/> Domestic <input type="checkbox"/> Public supply <input type="checkbox"/> Industry <input type="checkbox"/> Irrigation <input type="checkbox"/> Air conditioning <input checked="" type="checkbox"/> Stock <input type="checkbox"/> Lawn <input type="checkbox"/> Oil field water <input type="checkbox"/> Other	
						9. Casing: Material P145 Height: Above or below Threaded <input type="checkbox"/> Welded 91 Surface 18 in. RMP <input type="checkbox"/> PVC 8 Weight <input type="checkbox"/> lbs./ft. Dia. 5 in. to 200 ft. depth Wall Thickness: inches or Dia. <input type="checkbox"/> in. to <input type="checkbox"/> ft. depth gage No. 0258	
						10. Screen: Manufacturer's name Peerless Plastics Type PVC Dia. 5" Slot/gauze 1/16 Length 60 Set between 200 ft. and 260 ft. <input type="checkbox"/> ft. and <input type="checkbox"/> ft. Gravel pack? Yes Size range of material 1/8	
						11. Static water level: <input type="checkbox"/> mo./day/yr. 133 ft. below land surface Date 6/21/78	
(Use a second sheet if needed)						12. Pumping level below land surfaces: <input type="checkbox"/> ft. after <input type="checkbox"/> hrs. pumping <input type="checkbox"/> g.p.m. <input type="checkbox"/> ft. after <input type="checkbox"/> hrs. pumping <input type="checkbox"/> g.p.m. Estimated maximum yield 50 g.p.m.	
						13. Water sample submitted: <input type="checkbox"/> Yes <input checked="" type="checkbox"/> No Date <input type="checkbox"/>	
						14. Well head completion: <input type="checkbox"/> Pitless adapter 18 Inches above grade	
						15. Well grouted? Yes With: <input checked="" type="checkbox"/> Neat cement <input type="checkbox"/> Bentonite <input type="checkbox"/> Concrete Depth: From 3 ft. to 13 ft.	
						16. Nearest source of possible contamination: None ft. <input type="checkbox"/> Direction <input type="checkbox"/> Type <input type="checkbox"/> Well disinfected upon completion? <input checked="" type="checkbox"/> Yes <input type="checkbox"/> No	
18. Elevation:		19. Remarks: #16 Pasteur Well Pasteur #32 #17 Well to be completed at a later date		20. Water well contractor's certification: This well was drilled under my jurisdiction and this report is true to the best of my knowledge and belief. T+W Water Well 142 Business name License No. Address Box 816 Liberal, KS Signed C. Wanger Date 6/26/78 Authorized representative			
						17. Pump: <input checked="" type="checkbox"/> Not installed Manufacturer's name <input type="checkbox"/> Model number <input type="checkbox"/> HP <input type="checkbox"/> Volts <input type="checkbox"/> Length of drop pipe <input type="checkbox"/> ft. capacity <input type="checkbox"/> g.p.m. Type: <input type="checkbox"/> Submersible <input type="checkbox"/> Turbine <input type="checkbox"/> Jet <input type="checkbox"/> Reciprocating <input type="checkbox"/> Centrifugal <input type="checkbox"/> Other	
						Topography: <input type="checkbox"/> Hill <input type="checkbox"/> Slope <input checked="" type="checkbox"/> Upland <input type="checkbox"/> Valley	

34
400
7
NE 1/4
1/4
1/4