

County: Morton Fraction: NW, NW, NE, SE Sec. 2 T. 34 S R. 40 W

CORRECTION(S) to WATER WELL COMPLETION RECORD Form WWC-5 (to rectify lacking or incorrect information)

Owner: City of Rolla, KS PWS Well #7 ?

If location corrected, was listed as:

Location changed to:

Section-Township-Range: _____

Fraction (¼ calls): SE

NW, NW, NE, SE

Other changes: Initial statements: Location described as Washington & Adams, well ID not provided

Changed to: 50 ft NE of water tower, E of alley between Washington & Adams, and between 3rd & 4th.

Lat. 37.119774 deg N, Long. -101.632054 deg W (Google Earth WGS84).

Comments: City of Rolla staff reported well was referred to PWS #7.

Verification method: City staff reported location & well ID. Confirmed with STR Finder and Google Earth.

Initials: PKC Date: 8/6/2021

Submitted by: Kansas Geological Survey, Data Resources Library, 1930 Constant Ave., Lawrence, KS 66047-3724
 Kansas Dept. of Health & Environment, Bureau of Water, 1000 SW Jackson, Suite 420, Topeka, KS 66612-1367

WATER WELL PLUGGING RECORD Form WWC-5P KSA 82a-1212 ID NO.

[]


1 **LOCATION OF WATER WELL:** Fraction $\frac{1}{4}$ $\frac{1}{4}$ $\frac{1}{4}$ $\frac{1}{4}$ Section Number SE 2 Township Number T 34 S Range Number 40 E W
 County: Morton

Street/Rural Address of Well Location; if unknown, distance & direction from nearest town or intersection: If at owner's address, check here Washington + Adams

Global Positioning Systems (GPS) information:
 Latitude: _____ (in decimal degrees)
 Longitude: _____ (in decimal degrees)
 Elevation: _____
 Horizontal Datum: WGS84, NAD83, NAD27
 Collection Method:

2 **WATER WELL OWNER:** City of Rolla
 RR#, St. Address, Box #: 302 Washington St
 City, State ZIP Code: Rolla, KS 67954

GPS unit (Make/Model: _____)
 Digital Map/Photo, Topographic Map, Land Survey
 Est. Accuracy: < 3 m, 3-5 m, 5-15 m, > 15 m

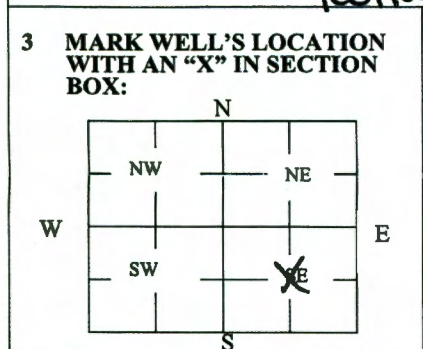

4 **DEPTH OF WELL** 435 ft.
WELL'S STATIC WATER LEVEL 122 ft.
WELL WAS USED AS:
 Domestic Public Water Supply Dewatering
 Irrigation Oil Field Water Supply Monitoring
 Feedlot Domestic (Lawn & Garden) Injection Well
 Industrial Air Conditioning Other _____
 Was a chemical/bacteriological sample submitted to Department? Yes No

5 **TYPE OF BLANK CASING USED:**
 Steel RMP (SR) Wrought Fiberglass Other (Specify below) _____
 PVC ABS Asbestos-Cement Concrete Tile
 Blank casing diameter 8 in. Was casing pulled? Yes No If yes, how much _____
 Casing height above or below land surface 36 in.

6 **GROUT PLUG MATERIAL:** Neat cement Cement grout Bentonite Other _____
 Grout Plug Intervals: From 435 ft. to 122 ft., From 122 ft. to 105 ft., From 105 ft. to 14 ft.
14ft to 3ft
 What is the nearest source of possible contamination:
 Septic tank Seepage pit Fuel storage Other (specify below) _____
 Sewer lines Pit privy Fertilizer storage
 Watertight sewer lines Sewage lagoon Insecticide storage
 Lateral lines Feedyard Abandoned water well
 Cess pool Livestock pens Oil well/Gas well
 Direction from well? South
 How many feet? 10 ft

FROM	TO	PLUGGING MATERIALS	FROM	TO	PLUGGING MATERIALS
435	122	Sand + Gravel			
122	105	Bentonite			
105	14	Sand			
14	3	Quick creet cement			
	3 ft	Steel plate welded on			

7 **CONTRACTOR'S OR LANDOWNER'S CERTIFICATION:** This water well was plugged under my jurisdiction and was completed on (mo/day/year) 3/18/19 and this record is true to the best of my knowledge and belief. Kansas Water Well Contractor's License No. _____ This Water Well Record was completed on (mo/day/year) 3/29/18 under the business name of M+T Pump Service LLC by (signature) Mike Colanton

Send one white copy to Kansas Department of Health & Environment, Geology Section, 1000 SW Jackson Street, Ste. 420, Topeka, KS 66612-1367. Send one copy to WATER WELL OWNER and retain one for your records.
 Visit us at <http://www.kdheks.gov/waterwell/index.html> Telephone 785-296-5524.