


1 LOCATION OF WATER WELL: Fraction NE 1/4 NE 1/4 NW 1/4 Section Number 4 Township Number T 34 Range Number R 21 E/W
 County: moston

Distance and direction from nearest town or city street address of well if located within city?
7 miles North to 25 East of Densmore Kansas

2 WATER WELL OWNER: Raymond Schick
 RR#, St. Address, Box #: Densmore Kansas 67633
 City, State, ZIP Code: Densmore Kansas 67633
 Board of Agriculture, Division of Water Resources
 Application Number:

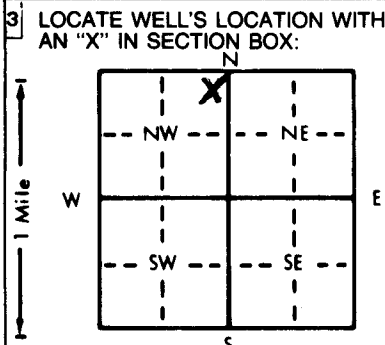

4 DEPTH OF COMPLETED WELL: 100 ft. ELEVATION: 100 ft.
 WELL'S STATIC WATER LEVEL 88 ft. below land surface measured on mo/day/yr Feb 26-92
 Pump test data: Well water was 88 ft. after 4 hours pumping 6 gpm
 Est. Yield 8 gpm: Well water was 88 ft. after 4 hours pumping 6 gpm
 Bore Hole Diameter 10 in. to 100 ft., and 100 in. to 100 ft.
 WELL WATER TO BE USED AS:
 1 Domestic 3 Feedlot 6 Oil field water supply 9 Dewatering 12 Other (Specify below)
 2 Irrigation 4 Industrial 7 Lawn and garden only 10 Monitoring well
 Was a chemical/bacteriological sample submitted to Department? Yes No If yes, mo/day/yr sample was submitted
 Water Well Disinfected? Yes No

5 TYPE OF BLANK CASING USED:
 1 Steel 3 RMP (SR) 5 Wrought iron 8 Concrete tile CASING JOINTS: Glued Clamped
 2 PVC 4 ABS 6 Asbestos-Cement 9 Other (specify below) Welded
 7 Fiberglass Threaded
 Casing height above land surface 20 in., weight 200 lbs./ft. Wall thickness or gauge No. SDR 21
 TYPE OF SCREEN OR PERFORATION MATERIAL:
 1 Steel 3 Stainless steel 5 Fiberglass 7 PVC 10 Asbestos-cement
 2 Brass 4 Galvanized steel 6 Concrete tile 8 RMP (SR) 11 Other (specify)
 9 ABS 12 None used (open hole)
 SCREEN OR PERFORATION OPENINGS ARE:
 1 Continuous slot 3 Mill slot 5 Gauzed wrapped 8 Saw cut 11 None (open hole)
 2 Louvered shutter 4 Key punched 6 Wire wrapped 9 Drilled holes
 7 Torch cut 10 Other (specify)

 What is the nearest source of possible contamination:
 1 Septic tank 4 Lateral lines 7 Pit privy 10 Livestock pens 14 Abandoned water well
 2 Sewer lines 5 Cess pool 8 Sewage lagoon 11 Fuel storage 15 Oil well/Gas well
 3 Watertight sewer lines 6 Seepage pit 9 Feedyard 12 Fertilizer storage 16 Other (specify below)
 13 Insecticide storage
 Direction from well? 600 feet to the West
 How many feet? 600 feet to the West

FROM		TO		LITHOLOGIC LOG	FROM	TO	PLUGGING INTERVALS
0	18	18	35	Surface Clay			
18	35	35	42	Yellow Hard Clay			
35	42	42	55	2 1/2" hole pack sand			
42	55	55	73	Hard Clay			
55	73	73	82	Soft Clay			
73	82	82	89	fine sand			
82	89	89	95	fine sand + 2 hole Rock			
89	95	95	100	hard sand			
95	100			Cray shale			

7 CONTRACTOR'S OR LANDOWNER'S CERTIFICATION: This water well was (1) constructed, (2) reconstructed, or (3) plugged under my jurisdiction and was completed on (mo/day/year) 2-2-92 and this record is true to the best of my knowledge and belief. Kansas Water Well Contractor's License No. 444 This Water Well Record was completed on (mo/day/yr) Feb 26-92 under the business name of Anderson Drilling by (signature) Andy Anderson

INSTRUCTIONS: Use typewriter or ball point pen. PLEASE PRESS FIRMLY and PRINT clearly. Please fill in blanks, underline or circle the correct answers. Send top three copies to Kansas Department of Health and Environment, Bureau of Water, Topeka, Kansas 66620-0001. Telephone: 913-296-5545. Send one to WATER WELL OWNER and retain one for your records.