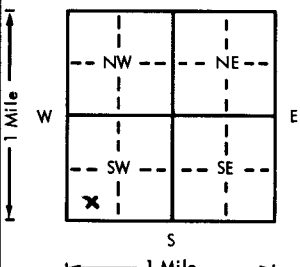


USE TYPEWRITER OR BALL  
POINT PEN-PRESS FIRMLY,  
PRINT CLEARLY.

WATER WELL RECORD  
KSA 82a-1201-1215

Kansas Department of Health and  
Environment-Division of Environment  
(Water well Contractors)  
Topeka, Kansas 66620

1. Location of well:		County <u>Morton</u>	Fraction <u>SW 1/4 SW 1/4 SW 1/4</u>	Section number <u>13</u>	Township number T <u>34</u> S R <u>41</u> E/W
2. Distance and direction from nearest town or city: <u>2 mi NE of Wilburton, KS.</u> Street address of well location if in city:				3. Owner of well: <u>Donald Coen</u> R.R. or street: <u>Rt 1 Box 59</u> City, state, zip code: <u>Elkhart, Kansas 67950</u>	
4. Locate with "X" in section below: N W E S 1 Mile		Sketch map: 		6. Bore hole dia. <u>9</u> in. Completion date <u>8/16/76</u> Well depth <u>310</u> ft.	
5. Type and color of material		From	To	7. <input type="checkbox"/> Cable tool <input checked="" type="checkbox"/> Rotary <input type="checkbox"/> Driven <input type="checkbox"/> Dug <input type="checkbox"/> Hollow rod <input type="checkbox"/> Jetted <input type="checkbox"/> Bored <input type="checkbox"/> Reverse rotary	
<u>Overburden</u>		<u>0</u>	<u>160</u>	8. Use: <input checked="" type="checkbox"/> Domestic <input type="checkbox"/> Public supply <input type="checkbox"/> Industry <input type="checkbox"/> Irrigation <input type="checkbox"/> Air conditioning <input type="checkbox"/> Stock <input type="checkbox"/> Lawn <input type="checkbox"/> Oil field water <input type="checkbox"/> Other	
<u>Fine Sand + Clay</u>		<u>160</u>	<u>195</u>	9. Casing: Material <u>PVC</u> Height: <u>Above</u> or below Threaded <input type="checkbox"/> Welded <input checked="" type="checkbox"/> Surface <u>14</u> in. RMP <input type="checkbox"/> PVC <input checked="" type="checkbox"/> Weight <u>      </u> lbs./ft. Dia. <u>5</u> in. to <u>260</u> ft. depth Wall Thickness: inches or Dia. <u>      </u> in. to <u>      </u> ft. depth Gage No. <u>0258</u>	
<u>Clay</u>		<u>195</u>	<u>210</u>	10. Screen: Manufacturer's name <u>S+L</u> Type <u>PVC</u> Dia. <u>5"</u> Slot/gauze <u>4/16</u> Length <u>50</u> Set between <u>260</u> ft. and <u>310</u> ft. <u>      </u> ft. and <u>      </u> ft. Gravel pack? <u>Yes</u> Size range of material <u>7/8"</u>	
<u>Medium Sand + Clay</u>		<u>210</u>	<u>250</u>	11. Static water level: <u>      </u> mo./day/yr. <u>160</u> ft. below land surface Date <u>8/16/76</u>	
<u>Medium to Coarse Sand + Clay</u>		<u>250</u>	<u>310</u>	12. Pumping level below land surfaces: <u>      </u> ft. after <u>      </u> hrs. pumping <u>      </u> g.p.m. <u>      </u> ft. after <u>      </u> hrs. pumping <u>      </u> g.p.m. Estimated maximum yield <u>40</u> g.p.m.	
				13. Water sample submitted: <u>      </u> mo./day/yr. <u>      </u> Yes <input checked="" type="checkbox"/> No <u>      </u> Date <u>      </u>	
				14. Well head completion: <u>      </u> Pitless adapter <u>14</u> inches above grade	
				15. Well grouted? <u>Yes</u> With: <input checked="" type="checkbox"/> Neat cement <input type="checkbox"/> Bentonite <input type="checkbox"/> Concrete Depth: From <u>3</u> ft. to <u>13</u> ft.	
				16. Nearest source of possible contamination: ft. <u>155</u> Direction <u>SE</u> Type <u>Septic</u> Well disinfected upon completion? <input checked="" type="checkbox"/> Yes <input type="checkbox"/> No	
				17. Pump: <input checked="" type="checkbox"/> Not installed Manufacturer's name <u>      </u> Model number <u>      </u> HP <u>      </u> Volts <u>      </u> Length of drop pipe <u>      </u> ft. capacity <u>      </u> g.p.m. Type: <input type="checkbox"/> Submersible <input type="checkbox"/> Turbine <input type="checkbox"/> Jet <input type="checkbox"/> Reciprocating <input type="checkbox"/> Centrifugal <input type="checkbox"/> Other	
18. Elevation:		19. Remarks: <u>Well to be Completed</u> <u>Stout Water Well Service</u> <u>Elkhart, KS.</u>			
Topography: <input type="checkbox"/> Hill <input checked="" type="checkbox"/> Slope <input type="checkbox"/> Upland <input type="checkbox"/> Valley		20. Water well contractor's certification: This well was drilled under my jurisdiction and this report is true to the best of my knowledge and belief. <u>T &amp; W Water Well</u> <u>142</u> Business name License No. Address <u>Box R16 Liberal, KS</u> Signed <u>[Signature]</u> Date <u>9/1/76</u> Authorized representative			

34 41 E  
T  
R  
W  
13-Subs  
1/4 1/4 1/4