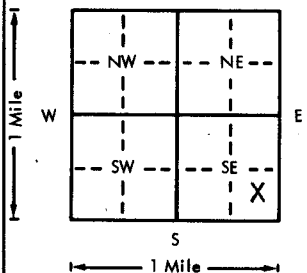


USE TYPEWRITER OR BALL
POINT PEN-PRESS FIRMLY,
PRINT CLEARLY.

WATER WELL RECORD
KSA 82a-1201-1215

Kansas Department of Health and
Environment-Division of Environment
(Water well Contractors)
Topeka, Kansas 66620

1. Location of well:		County MORTON	Fraction SE 1/4 SE 1/4 SE 1/4	Section number 22	Township number T 34 S	Range number R 41 E		
2. Distance and direction from nearest town or city: 7 Miles East & Street address of well location if in city: 4 miles North of Elkhart			3. Owner of well: CLINT THOMASON R.R. or street: Box 1068 City, state, zip code: Elkhart, KS 67950					
4. Locate with "X" in section below: N W E S 1 Mile Sketch map: 			6. Bore hole dia. 26 in. Completion date 4-17-84 Well depth 320 ft.					
5. Type and color of material			7. <input type="checkbox"/> Cable tool <input checked="" type="checkbox"/> Rotary <input type="checkbox"/> Driven <input type="checkbox"/> Dug <input type="checkbox"/> Hollow rod <input type="checkbox"/> Jetted <input type="checkbox"/> Bored <input type="checkbox"/> Reverse rotary					
			8. Use: <input type="checkbox"/> Domestic <input type="checkbox"/> Public supply <input type="checkbox"/> Industry <input checked="" type="checkbox"/> Irrigation <input type="checkbox"/> Air conditioning <input type="checkbox"/> Stock <input type="checkbox"/> Lawn <input type="checkbox"/> Oil field water <input type="checkbox"/> Other					
			9. Casing: Material Steel Height: Above or below Threaded <input type="checkbox"/> Welded <input checked="" type="checkbox"/> Surface 12 in. RMP <input type="checkbox"/> PVC <input type="checkbox"/> Weight 42.5 lbs./ft. Dia. 16 in. to 320 ft. depth Wall Thickness: inches or Dia. <input type="checkbox"/> in. to <input type="checkbox"/> ft. depth gage No. 250					
			10. Screen: Manufacturer's name _____ Type Steel Dia. 16" Slot/gauze 1/8 Length 3 Set between 220 ft. and 260 ft. _____ ft. and _____ ft. Gravel pack? yes Size range of material 1/8-1/4					
(Use a second sheet if needed)			From	To	11. Static water level: _____ mo./day/yr. _____ ft. below land surface Date _____			
			Top soil		0	152	12. Pumping level below land surfaces: N/A _____ ft. after _____ hrs. pumping _____ g.p.m. _____ ft. after _____ hrs. pumping _____ g.p.m. Estimated maximum yield _____ g.p.m.	
			Fine & med sand w/clay streak		152	220	13. Water sample submitted: _____ mo./day/yr. Yes <input checked="" type="checkbox"/> No <input type="checkbox"/> Date _____	
			Med coarse sand w/clay streak		220	260	14. Well head completion: N/A <input type="checkbox"/> Pitless adapter _____ inches above grade	
			Sand stone w/clay streak		260	320	15. Well grouted? yes With: <input checked="" type="checkbox"/> Neat cement <input type="checkbox"/> Bentonite <input type="checkbox"/> Concrete Depth: From <input type="checkbox"/> ft. to 10 ft.	
							16. Nearest source of possible contamination: ft. _____ Direction _____ Type _____ Well disinfected upon completion? Yes <input type="checkbox"/> No <input checked="" type="checkbox"/>	
							17. Pump: <input checked="" type="checkbox"/> Not installed Manufacturer's name _____ Model number _____ HP _____ Volts _____ Length of drop pipe _____ ft. capacity _____ g.p.m. Type: <input type="checkbox"/> Submersible <input type="checkbox"/> Turbine <input type="checkbox"/> Jet <input type="checkbox"/> Reciprocating <input type="checkbox"/> Centrifugal <input type="checkbox"/> Other	
							20. Water well contractor's certification: This well was drilled under my jurisdiction and this report is true to the best of my knowledge and belief. KTM DRILLING, INC. 225 Business name License No. Address Box 1385, Guzman, OK Signed <i>[Signature]</i> Date 4/20/84 Authorized representative	
			18. Elevation:		19. Remarks: Perf. 160-220 and 260-320 Application Number 37062			
			Topography: <input type="checkbox"/> Hill <input checked="" type="checkbox"/> Slope <input type="checkbox"/> Upland <input type="checkbox"/> Valley					