

USE TYPEWRITER OR BALL  
POINT PEN-PRESS FIRMLY,  
PRINT CLEARLY.

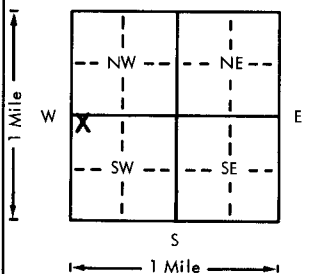
WATER WELL RECORD  
KSA 82a-1201-1215

Kansas Department of Health and  
Environment-Division of Environment  
(Water well Contractors)

Topeka, Kansas 66629

0429A0003 307 2752193

1.00

1. Location of well:		County <b>MORTON</b>	Fraction <b>NW 1/4 NW 1/4 SW 1/4</b>	Section number <b>26</b>	Township number <b>T 34</b>	Range number <b>S R 41</b>	E/W
2. Distance and direction from nearest town or city: <b>10-3/4 miles Northeast of Elkhart</b> Street address of well location if in city:				3. Owner of well: <b>CLINT THOMASON</b> R.R. or street: <b>BOX 1067</b> City, state, zip code: <b>ELKHART, KS 67950</b>			
4. Locate with "X" in section below: N W E S 1 Mile		Sketch map: 		6. Bore hole dia. <b>26</b> in. Completion date <b>5-31-82</b> Well depth <b>288</b> ft.			
5. Type and color of material		From	To	7. <input checked="" type="checkbox"/> Cable tool <input checked="" type="checkbox"/> Rotary <input type="checkbox"/> Driven <input type="checkbox"/> Dug <input type="checkbox"/> Hollow rod <input type="checkbox"/> Jetted <input type="checkbox"/> Bored <input type="checkbox"/> Reverse rotary			
Over burden		0	160	8. Use: <input checked="" type="checkbox"/> Domestic <input type="checkbox"/> Public supply <input type="checkbox"/> Industry <input checked="" type="checkbox"/> Irrigation <input type="checkbox"/> Air conditioning <input type="checkbox"/> Stock <input type="checkbox"/> Lawn <input type="checkbox"/> Oil field water <input type="checkbox"/> Other			
Fine sand & clay stks.		160	180	9. Casing: Material <b>Steel</b> Height: Above or below Threaded <input type="checkbox"/> Welded <input checked="" type="checkbox"/> Surface <b>12</b> in. RMP <b>16</b> <b>288</b> Weight <b>42.5</b> lbs./ft. Dia. <b>16</b> in. to <b>288</b> ft. depth Wall Thickness <b>1/8</b> inches or Dia. <b>16</b> in. to <b>288</b> ft. depth Gauge No. <b>.250</b>			
Med sand & clay		180	220	10. Screen: Manufacturer's name <b>Johnson Screen</b> Type <b>Steel</b> Dia. <b>16</b> Slot/gauze <b>1/8</b> Length <b>3</b> Set between <b>220</b> ft. and <b>250</b> ft. ft. and <b>250</b> ft. Gravel pack? <input checked="" type="checkbox"/> Size range of material <b>18-24</b>			
Med-coarse sand & rock stks.		220	260	11. Static water level: <b>145</b> ft. below land surface Date <b>5-31-82</b>			
Coarse sand & gravel		260	280	12. Pumping level below land surfaces: <b>N/A</b> ft. after <b>0</b> hrs. pumping <b>0</b> g.p.m. ft. after <b>0</b> hrs. pumping <b>0</b> g.p.m. Estimated maximum yield <b>0</b> g.p.m.			
Clay & red bed		280	310	13. Water sample submitted: <b>0</b> mo./day/yr. <input checked="" type="checkbox"/> Yes <input type="checkbox"/> No Date <b>5-31-82</b>			
				14. Well head completion: <b>N/A</b> <input type="checkbox"/> Pitless adapter <b>0</b> inches above grade			
				15. Well grouted? <input checked="" type="checkbox"/> With: <input checked="" type="checkbox"/> Neat cement <input type="checkbox"/> Bentonite <input type="checkbox"/> Concrete Depth: From <b>0</b> ft. to <b>10</b> ft.			
				16. Nearest source of possible contamination: ft. <b>0</b> Direction <b>0</b> Type <b>0</b> Well disinfected upon completion? <input checked="" type="checkbox"/> Yes <input type="checkbox"/> No			
				17. Pump: <input checked="" type="checkbox"/> Not installed Manufacturer's name <b>0</b> Model number <b>0</b> HP <b>0</b> Volts <b>0</b> Length of drop pipe <b>0</b> ft. capacity <b>0</b> g.p.m. Type: <input type="checkbox"/> Submersible <input type="checkbox"/> Turbine <input type="checkbox"/> Jet <input type="checkbox"/> Reciprocating <input type="checkbox"/> Centrifugal <input type="checkbox"/> Other			
18. Elevation:		19. Remarks:		20. Water well contractor's certification: This well was drilled under my jurisdiction and this report is true to the best of my knowledge and belief. <b>KTM DRILLING, INC. 225</b> Business name <b>Box 1305, Guyman, OK</b> License No. <b>0</b> Address <b>0</b> Signed <b>0</b> Date <b>5/31/82</b> Authorized representative			
Topography: <input type="checkbox"/> Hill <input checked="" type="checkbox"/> Slope <input type="checkbox"/> Upland <input type="checkbox"/> Valley		16. Cropland					

34  
41  
26  
1/4 1/4 1/4