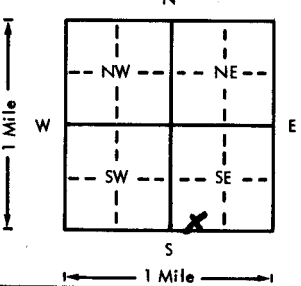


USE TYPEWRITER OR BALL
POINT PEN-PRESS FIRMLY,
PRINT CLEARLY.

WATER WELL RECORD
KSA 82a-1201-1215

Kansas Department of Health and
Environment-Division of Environment
(Water well Contractors)
Topeka, Kansas 66620

1. Location of well:		County Morton	Fraction SE 1/4 SW 1/4 SE 1/4	Section number 26	Township number T 34 S	Range number R 41 E/W
2. Distance and direction from nearest town or city: 1 3/4 EAST OF WICK BURTON, KAN			3. Owner of well: Clint Thomasson R.R. or street: Box 433 City, state, zip code: Elkhart, Kansas			
4. Locate with "X" in section below: 			Sketch map:			
5. Type and color of material			From	To	6. Bore hole dia. 26 in. Completion date Well depth 289 ft. 6-18-76	
Overburden				2	7. Cable tool <input checked="" type="checkbox"/> Rotary <input type="checkbox"/> Driven <input type="checkbox"/> Dug <input type="checkbox"/> Hollow rod <input type="checkbox"/> Jetted <input type="checkbox"/> Bored <input type="checkbox"/> Reverse rotary	
Top Soil				2	8. Use: <input type="checkbox"/> Domestic <input type="checkbox"/> Public supply <input type="checkbox"/> Industry <input checked="" type="checkbox"/> Irrigation <input type="checkbox"/> Air conditioning <input type="checkbox"/> Stock <input type="checkbox"/> Lawn <input type="checkbox"/> Oil field water <input type="checkbox"/> Other	
Clay Strks. & Sand			162	193	9. Casing: Material Steel Height: Above or below Threaded <input type="checkbox"/> Welded <input checked="" type="checkbox"/> Surface 12 in. RMP <input type="checkbox"/> PVC <input type="checkbox"/> Weight 42.5 lbs./ft. Dia. 16 in. to 289 ft. depth Wall Thickness: inches or Dia. <input type="checkbox"/> in. to <input type="checkbox"/> ft. depth gage No. 250	
Med. & Fine Sd.			193	287	10. Screen: Manufacturer's name L.B. Foster Type Steel Dia. 16 Slot/gauze 1/8 Length 9 Set between 179 ft. and 250 ft. 270 ft. and 289 ft. Gravel pack? yes Size range of material 1/8-1/4	
Med. Sd. & Clay Strks.			287	290	11. Static water level: 152 ft. below land surface Date 6/19/76 mo./day/yr.	
Clay - Red Bed			290	300	12. Pumping level below land surfaces: NA ____ ft. after ____ hrs. pumping ____ g.p.m. ____ ft. after ____ hrs. pumping ____ g.p.m. Estimated maximum yield ____ g.p.m.	
					13. Water sample submitted: ____ mo./day/yr. Yes <input checked="" type="checkbox"/> No <input type="checkbox"/> Date ____	
					14. Well head completion: NA ____ Pitless adapter ____ inches above grade	
					15. Well grouted? yes With: <input checked="" type="checkbox"/> Neat cement <input type="checkbox"/> Bentonite <input type="checkbox"/> Concrete Depth: From 0 ft. to 10 ft.	
					16. Nearest source of possible contamination: ft. ____ Direction ____ Type ____ Well disinfected upon completion? ____ Yes <input checked="" type="checkbox"/> No	
					17. Pump: <input checked="" type="checkbox"/> Not installed Manufacturer's name ____ Model number ____ HP ____ Volts ____ Length of drop pipe ____ ft. capacity ____ g.p.m. Type: ____ Submersible ____ Turbine ____ Jet ____ Reciprocating ____ Centrifugal ____ Other	
18. Elevation:			19. Remarks: 10a Johnson Ier 1100 Slot Steel 16" 250-270' 16a Crop Land		20. Water well contractor's certification: This well was drilled under my jurisdiction and this report is true to the best of my knowledge and belief. KTM DRILLING, INC. 225 Business name Box 1385, Gayman, Okla. License No. ____ Address ____ Signed [Signature] Date 8/30 Authorized representative	