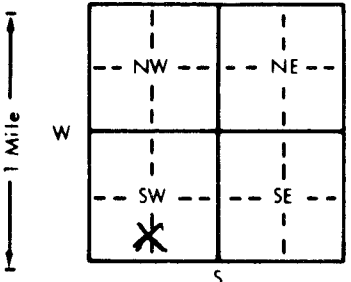


1 LOCATION OF WATER WELL:		Fraction	Section Number	Township Number	Range Number
County: MORTON		NC 1/4 S 1/2 1/4 SW 1/4	31	T 34 S	R 41 EW
Distance and direction from nearest town or city street address of well if located within city? FROM WILBURTON 3 SOUTHWEST ON 56, 1/2 SOUTH 1/2 EAST NORTH INTO LOC.					
2 WATER WELL OWNER: ANADARKO PETROLEUM		NUSSER A-1 Board of Agriculture, Division of Water Resources Application Number: (applied for)			
RR#, St. Address, Box #: 9400 N. BROADWAY, STE. 700					
City, State, ZIP Code: OKLAHOMA CITY, OK 73114					
3 LOCATE WELL'S LOCATION WITH AN "X" IN SECTION BOX:		4 DEPTH OF COMPLETED WELL: 280 ft. ELEVATION: (applied for)			
<div style="text-align: center;">N W E S</div> 		Depth(s) Groundwater Encountered 1 ft. 2. ft. 3. ft.			
		WELL'S STATIC WATER LEVEL 80 ft. below land surface measured on mo/day/yr 6-15-94			
		Pump test data: Well water was ft. after hours pumping gpm			
		Est. Yield gpm: Well water was ft. after hours pumping gpm			
Bore Hole Diameter 9 1/2 in. to 280 ft., and in. to ft.					
WELL WATER TO BE USED AS:		5 Public water supply 8 Air conditioning 11 Injection well			
1 Domestic 3 Feedlot 6 Oil field water supply 9 Dewatering 12 Other (Specify below)					
2 Irrigation 4 Industrial 7 Lawn and garden only 10 Monitoring well					
Was a chemical/bacteriological sample submitted to Department? Yes No X; If yes, mo/day/yr sample was submitted		Water Well Disinfected? Yes X No			
5 TYPE OF BLANK CASING USED:		CASING JOINTS: Glued X Clamped			
1 Steel 3 RMP (SR) 6 Asbestos-Cement 9 Other (specify below) Welded					
2 PVC 4 ABS 7 Fiberglass Threaded					
Blank casing diameter 5 in. to 280 ft., Dia in. to ft., Dia in. to ft.					
Casing height above land surface 24 in., weight 2.902 lbs./ft. Wall thickness or gauge No. 265 SDR 21					
TYPE OF SCREEN OR PERFORATION MATERIAL:		7 PVC 10 Asbestos-cement			
1 Steel 3 Stainless steel 5 Fiberglass 8 RMP (SR) 11 Other (specify)					
2 Brass 4 Galvanized steel 6 Concrete tile 9 ABS 12 None used (open hole)					
SCREEN OR PERFORATION OPENINGS ARE:		5 Gauzed wrapped 8 Saw cut 11 None (open hole)			
1 Continuous slot 3 Mill slot 6 Wire wrapped 9 Drilled holes					
2 Louvered shutter 4 Key punched 7 Torch cut 10 Other (specify)					
SCREEN-PERFORATED INTERVALS: From 200 ft. to 280 ft., From ft. to ft.					
GRAVEL PACK INTERVALS: From 80 ft. to 280 ft., From ft. to ft.					
6 GROUT MATERIAL: 1 Neat cement 2 Cement grout 3 Bentonite 4 Other HOLE PLUG					
Grout Intervals: From 1 ft. to 20 ft., From ft. to ft., From ft. to ft.					
What is the nearest source of possible contamination:		10 Livestock pens 14 Abandoned water well			
1 Septic tank 4 Lateral lines 7 Pit privy 11 Fuel storage 15 Oil well/Gas well					
2 Sewer lines 5 Cess pool 8 Sewage lagoon 12 Fertilizer storage 16 Other (specify below)					
3 Watertight sewer lines 6 Seepage pit 9 Feedyard 13 Insecticide storage					
Direction from well?		How many feet?			
FROM	TO	LITHOLOGIC LOG	FROM	TO	PLUGGING INTERVALS
0	2	TOP			
2	36	CLAY			
36	60	SANDY CLAY			
60	160	SANDY CLAY W/ SAND STREAKS			
160	271	SAND			
271	280	RED BED			
7 CONTRACTOR'S OR LANDOWNER'S CERTIFICATION: This water well was (1) constructed, (2) reconstructed, or (3) plugged under my jurisdiction and was completed on (mo/day/year) 6-15-94 and this record is true to the best of my knowledge and belief. Kansas Water Well Contractor's License No. KWWCL-430. This Water Well Record was completed on (mo/day/year) 6-15-94 under the business name of HOWARD DRUG CO. BOX 806 BEAVER, OK 73932 by (signature) Howard					
INSTRUCTIONS: Use typewriter or ball point pen. PLEASE PRESS FIRMLY and PRINT clearly. Please fill in blanks, underline or circle the correct answers. Send top three copies to Kansas Department of Health and Environment, Bureau of Water, Topeka, Kansas 66620-0001. Telephone: 913-296-5545. Send one to WATER WELL OWNER and retain one for your records.					