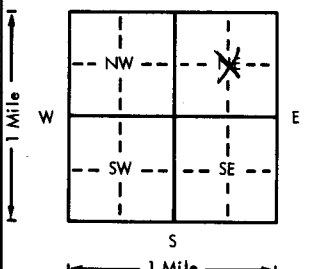


USE TYPEWRITER OR BALL
POINT PEN-PRESS FIRMLY,
PRINT CLEARLY.

WATER WELL RECORD
KSA 82a-1201-1215

Kansas Department of Health and
Environment-Division of Environment
(Water well Contractors)
Topeka, Kansas 66620

CWW Inv. #12926

1. Location of well:		County Morton	Fraction 1/4 1/4C-NE/4	Section number 32	Township number T 34 S	Range number R 41 E/W
2. Distance and direction from nearest town or city: From Wilburton 1 mi. West- 1 1/4 mi. Southwest to loc.			3. Owner of well: Cities Service Oil Co. R.R. or street: 3545 N.W. 58th Street City, state, zip code: Okla. City, Oklahoma 73112			
4. Locate with "X" in section below: 			6. Bore hole dia. 9 in. Completion date 11/30/76 Well depth 260			
5. Type and color of material			7. <input checked="" type="checkbox"/> Cable tool <input checked="" type="checkbox"/> Rotary <input type="checkbox"/> Driven <input type="checkbox"/> Dug <input type="checkbox"/> Hollow rod <input type="checkbox"/> Jetted <input type="checkbox"/> Bored <input type="checkbox"/> Reverse rotary			
			8. Use: <input type="checkbox"/> Domestic <input type="checkbox"/> Public supply <input checked="" type="checkbox"/> Industry <input type="checkbox"/> Irrigation <input type="checkbox"/> Air conditioning <input type="checkbox"/> Stock <input type="checkbox"/> Lawn <input checked="" type="checkbox"/> Oil field water <input type="checkbox"/> Other			
			9. Casing: Material <input type="checkbox"/> Height: <input type="checkbox"/> Above or below Threaded <input type="checkbox"/> Welded <input type="checkbox"/> Surface 28 in. RMP <input type="checkbox"/> PVC <input checked="" type="checkbox"/> Weight 2.78 lbs./ft. Dia. 5 in. to 170 depth; Wall Thickness: inches or Dia. 5 in. to 260 depth; gage No. 265			
			10. Screen: Manufacturer's name Sawed Perf. Type PVC Dia. 5 Slot/gauze 030 Length 80 Set between 170 ft. and 250 ft. ft. and 250 ft. Gravel pack? yes Size range of material 1/8-3/16			
			11. Static water level: 140 ft. below land surface Date 11/30/76 mo./day/yr.			
(Use a second sheet if needed)			12. Pumping level below land surfaces: ft. after hrs. pumping g.p.m. ft. after hrs. pumping g.p.m. Estimated maximum yield 50 g.p.m.			
			13. Water sample submitted: Yes <input checked="" type="checkbox"/> No <input type="checkbox"/> Date			
			14. Well head completion: Pitless adapter 28 inches above grade			
			15. Well grouted? yes With: <input checked="" type="checkbox"/> Neat cement <input type="checkbox"/> Bentonite <input type="checkbox"/> Concrete Depth: From 0 ft. to 10 ft.			
			16. Nearest source of possible contamination: ft. 100 Direction NE Type oil well Well disinfected upon completion? <input checked="" type="checkbox"/> Yes <input type="checkbox"/> No			
18. Elevation:			17. Pump: <input checked="" type="checkbox"/> Not installed Manufacturer's name Model number HP Volts Length of drop pipe ft. capacity g.p.m. Type: <input type="checkbox"/> Submersible <input type="checkbox"/> Turbine <input type="checkbox"/> Jet <input type="checkbox"/> Reciprocating <input type="checkbox"/> Centrifugal <input type="checkbox"/> Other			
			20. Water well contractor's certification: This well was drilled under my jurisdiction and this report is true to the best of my knowledge and belief. Carlile Water Wells 118 Business name License No. Address Box 275 Liberal, KS. Signed Edward E. Means Date 12-6-76 Authorized representative			
			19. Remarks:			
			Topography: <input type="checkbox"/> Hill <input type="checkbox"/> Slope <input checked="" type="checkbox"/> Upland <input type="checkbox"/> Valley			

76

16

3
4
4
11
32
1/4
1/4
1/4
1/4

Sec

1/4

1/4

1/4

1/4