WATER WELL RECORD Form WWC-5 KSA 82a-1212

1 LOCATION OF WATER WELL: County: **Morton** | Fraction: **SW ¼ SE ¼ NE ¼** | Section Number: **29** | Township Number: **T 34 S** | Range Number: **R 43 E/W**

Distance and direction from nearest town or city street address of well if located within city?
8 mi. WNW of Hwy 27 & County Road D

2 WATER WELL OWNER: Anadarko Petroleum Corp.
RR#, St. Address, Box # : 1201 Lake Robbins Drive
City, State, ZIP Code : The Woodlands, TX 77380
Board of Agriculture, Division of Water Resources Application Number:

3 LOCATE WELL'S LOCATION WITH AN "X" IN SECTION BOX:

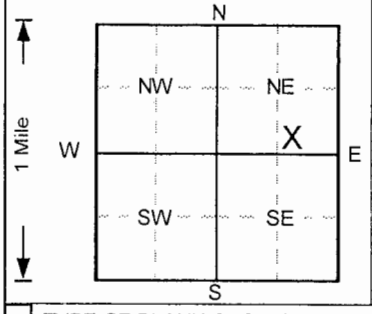

4 DEPTH OF COMPLETED WELL **18** ft. ELEVATION:
Depth(s) Groundwater Encountered 1. ft. 2. ft. 3. ft.
WELL'S STATIC WATER LEVEL ft. below land surface measured on mo/day/yr
Pump test data: Well water was **NA** ft. after hours pumping gpm
Est. Yield **NA** gpm: Well water was ft. after hours pumping gpm
Bore Hole Diameter **8** in. to **18** ft., and in. to ft.
WELL WATER TO BE USED AS: 5 Public water supply 8 Air conditioning 11 Injection well
1 Domestic 3 Feedlot 6 Oil field water supply 9 Dewatering 12 Other (Specify below)
2 Irrigation 4 Industrial 7 Lawn and garden only **(10) Monitoring well**
Was a chemical/bacteriological sample submitted to Department? Yes.....No ✓; If yes, mo/day/yr sample was submitted
Water Well Disinfected? Yes No ✓

5 TYPE OF BLANK CASING USED: 5 Wrought iron 8 Concrete tile CASING JOINTS: Glued Clamped
1 Steel 3 RMP (SR) 6 Asbestos-Cement 9 Other (specify below) Welded
(2) PVC 4 ABS 7 Fiberglass Threaded ✓
Blank casing diameter **2** in. to **8** ft., Dia in. to ft., Dia in. to ft.
Casing height above land surface **0** in., weight lbs./ft. Wall thickness or gauge No. **Sch. 40**

TYPE OF SCREEN OR PERFORATION MATERIAL
1 Steel 3 Stainless steel 5 Fiberglass **(7)** PVC 10 Asbestos-cement
2 Brass 4 Galvanized steel 6 Concrete tile 8 RMP (SR) 11 Other (specify)
9 ABS 12 None used (open hole)

SCREEN OR PERFORATION OPENINGS ARE:
1 Continuous slot **(3)** Mill slot 5 Gauzed wrapped 8 Saw cut 11 None (open hole)
2 Louvered shutter 4 Key punched 6 Wire wrapped 9 Drilled holes
7 Torch cut 10 Other (specify)

SCREEN-PERFORATED INTERVALS: From **8** ft. to **18** ft., From ft. to ft.
From ft. to ft., From ft. to ft.
GRAVEL PACK INTERVALS: From **6** ft. to **18** ft., From ft. to ft.
From ft. to ft., From ft. to ft.

6 GROUT MATERIAL: 1 Neat cement **(2)** Cement grout **(3)** Bentonite 4 Other
Grout Intervals: From **0** ft. to **2** ft., From **2** ft. to **6** ft., From ft. to ft.

What is the nearest source of possible contamination:
1 Septic tank 4 Lateral lines 7 Pit privy 10 Livestock pens 14 Abandoned water well
2 Sewer lines 5 Cess pool 8 Sewage lagoon 11 Fuel storage 15 Oil well/Gas well
3 Watertight sewer lines 6 Seepage pit 9 Feedyard 12 Fertilizer storage 16 Other (specify below)
13 Insecticide storage
Direction from well? How many feet? **0**

FROM	TO	LITHOLOGIC LOG	FROM	TO	PLUGGING INTERVALS
0	0.5	Sand, silty, dry, loose, weak cementation, Dar	15	16.5	Sand w/gravel, saturated, v. loose, Gray
0.5	1.3	Sand, silty, dry, v. loose, weak cementation, Br	16.5	18	No Recovery,
1.3	3	No Recovery,			
3	4	Sand, silty, dry, loose, weak cementation, Yell			
4	6	Sand, silty, dry, loose, weak cementation, Bro			
6	8.1	Sand, silty, dry, v. loose, weak cementation, Lt			
8.1	8.5	Clay/Gravel/Sand layer,			
8.5	9.5	Sand, silty, dry, v. loose, weak cementation, Lt			
9.5	10	No Recovery,			
10	10.6	As above, v. moist to almost wet,			
10.6	11.4	Sand, silty, wet to saturated, v. loose, Brown			
11.4	12.2	Sand, wet, v. loose, weak cementation, Lt. Yell			
12.2	13	No Recovery,			MW15
13	14.5	Sand, saturated, v. loose, weak cementation, G			Project Name: Arcadis - Elkhart NW
14.5	15	No Recovery,			GeoCore # 1255 , #

7 CONTRACTOR'S OR LANDOWNER'S CERTIFICATION: This water well was **(1)** constructed, (2) reconstructed, or (3) plugged under my jurisdiction and was completed on (mo/day/year) **11/8/2005** and this record is true to the best of my knowledge and belief. Kansas Water Well Contractor's License No. **527** This Water Well Record was completed on (mo/day/yr) **11/22/2005** under the business name of **GeoCore, Inc.** by (signature) Dale Bell

INSTRUCTIONS: Use typewriter or ball point pen. *PLEASE PRESS FIRMLY* and *PRINT* clearly. Please fill in blanks, underline or circle the correct answers. Send top three copies to Kansas Department of Health and Environment, Bureau of Water, Topeka, Kansas 66620-0001. Telephone: 913-296-5545. Send one to WATER WELL OWNER and retain one for your records.

OFFICE USE ONLY T R E/W SEC. ¼ ¼ ¼