


Division of Water Resources App. No.

KSA 82a-1212

Check: ☐ White Copy, ☐ Blue Copy, ☐ Pink Copy

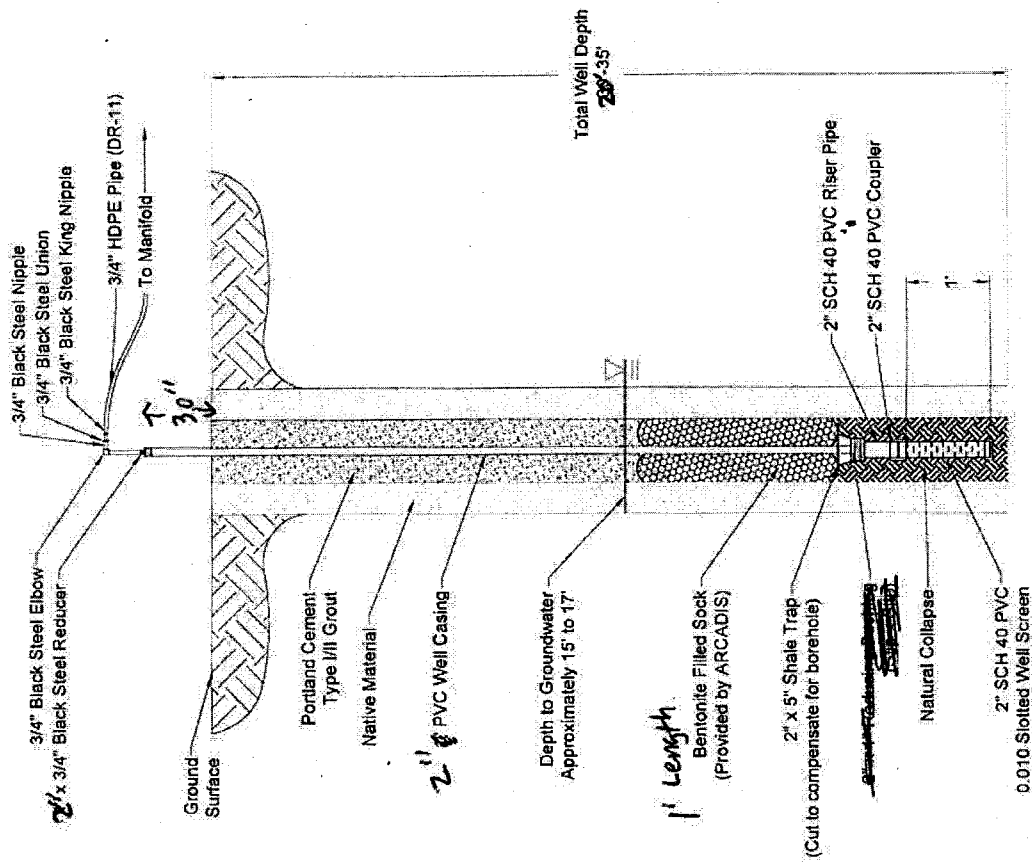

Air Sparge Well
Not To Scale

- Notes:
1. All black steel pipe and fittings are Schedule 40 steel.
 2. All PVC pipe and fittings are Schedule 40 PVC.

Prepared by:	ARCADIS	Designed by:	TLS
Checked by:		Drawn by:	TLS
Reviewed by:		Construction Details:	KMS
Format:	Interstate Gas Plant - Elkhart, Kansas	Investigation Agreement:	NA
Investigation Agreement No.:	98-VCF-0001	Project No.:	4
Project Name:	ARCADIS	Date:	09/10/12



Not To Scale

