


Division of Water Resources App. No.

Check: ☐ White Copy, ☐ Blue Copy, ☐ Pink Copy

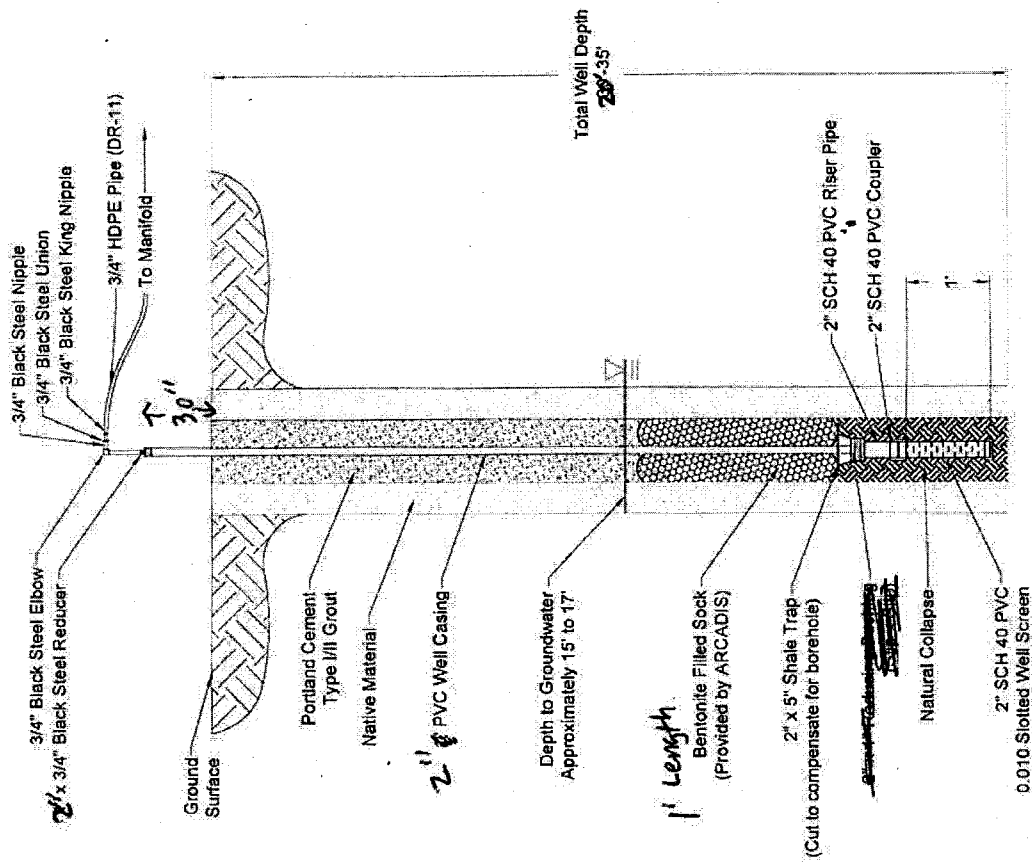

Air Sparge Well
Not To Scale

- Notes:
1. All black steel pipe and fittings are Schedule 40 steel.
 2. All PVC pipe and fittings are Schedule 40 PVC.

Prepared by:	ARCADIS	Designed by:	TLS
Checked by:		Drawn by:	TLS
Reviewed by:		Construction Details:	KMS
Format Interests Gas Plant - Elkhart, Kansas		Investigation Agreement:	NA
Investigation Agreement No. 98-VCP-0001		Project No.:	4
Project Name:	ARCADIS	Date:	09/10/12




Not To Scale

LEGEND

- Monitoring wells
- Abandoned monitoring well
- Pilot test observation wells
- Existing Air sparge wells
- Proposed Air sparge wells
- Soil vapor extraction (SVE) wells
- Bio-sparge wells (Converted SVE wells)
- SVE pipe runs (existing)
- Aboveground pipe - 3/4" HOPE
- Overhead power line
- Power pole
- Fence
- Buried power line
- Buried pipeline (active)

NOTE:
Well MW3 was abandoned during soil removal activities

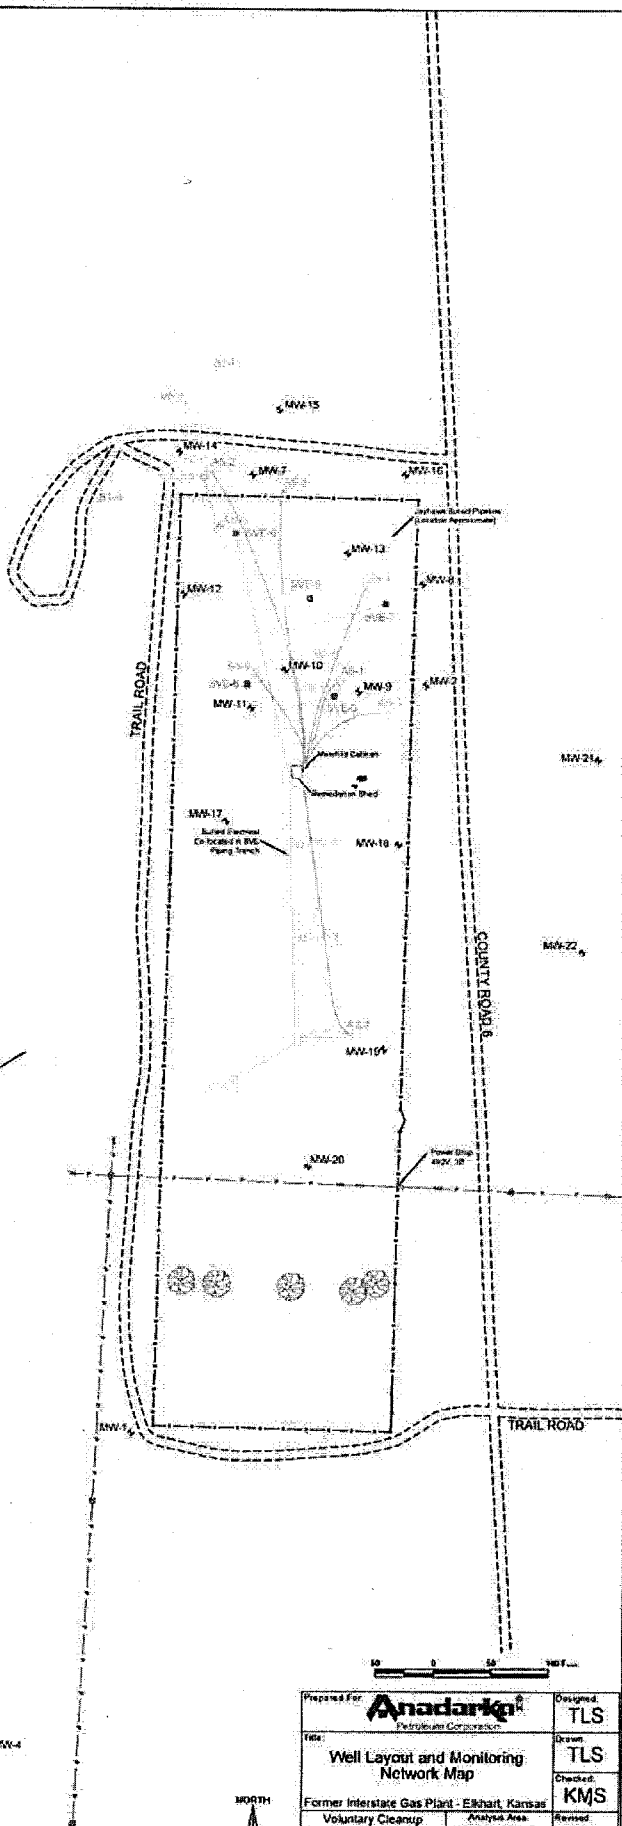

Prepared For:	Anadarko Petroleum Corporation	Designed:	TLS
Title:	Well Layout and Monitoring Network Map	Drawn:	TLS
Former Interstate Gas Plant - Elkhart, Kansas		Checked:	KMS
Voluntary Cleanup Investigation Agreement No. 98-VCP-0801	Analysis Area: MORTON COUNTY, KANSAS	Revised:	NA
ARCADIS	Date: 07/11/12	Figure:	3