

WATER WELL PLUGGING RECORD Form WWC-5P KSA 82a-1212 ID NO.

SVE-3

1 LOCATION OF WATER WELL: County: Morton	Fraction SW 1/4 SE 1/4 NE 1/4 1/4	Section Number 29	Township Number T 34S	Range Number 43 <input type="checkbox"/> E <input checked="" type="checkbox"/> W
--	--------------------------------------	----------------------	--------------------------	---

Street/Rural Address of Well Location; if unknown, distance & direction from nearest town or intersection: If at owner's address, check here

4 Miles North and 6.75 Miles West of Elkhart, Kansas

Global Positioning Systems (GPS) information:

Latitude: 37.061706948 (in decimal degrees)

Longitude: -102.011198019 (in decimal degrees)

Elevation:

Datum: WGS84, NAD83, NAD27


Collection Method:

GPS unit (Make/Model: _____)
 Digital Map/Photo, Topographic Map, Land Survey

Est. Accuracy: < 3 m. 3-5 m. 5-15 m. > 15 m

2 WATER WELL OWNER: Anadarko Petroleum Company
 RR#, St. Address, Box #: 1201 Lake Robbins Drive
 City, State ZIP Code: The Woodlands, TX 77380

3 MARK WELL'S LOCATION WITH AN "X" IN SECTION BOX:

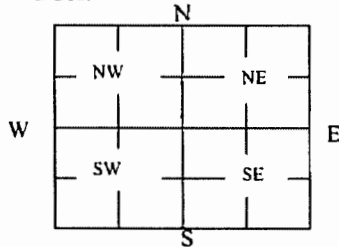

4 DEPTH OF WELL 24.6' ft.

WELL'S STATIC WATER LEVEL 23' ft

WELL WAS USED AS:

- | | | |
|-------------------------------------|---|---|
| <input type="checkbox"/> Domestic | <input type="checkbox"/> Public Water Supply | <input type="checkbox"/> Dewatering |
| <input type="checkbox"/> Irrigation | <input type="checkbox"/> Oil Field Water Supply | <input type="checkbox"/> Monitoring |
| <input type="checkbox"/> Feedlot | <input type="checkbox"/> Domestic (Lawn & Garden) | <input type="checkbox"/> Injection Well |
| <input type="checkbox"/> Industrial | <input type="checkbox"/> Air Conditioning | <input type="checkbox"/> Other _____ |

Was a chemical/bacteriological sample submitted to Department? Yes No

5 TYPE OF BLANK CASING USED:

- Steel RMP (SR) Wrought Fiberglass Other (Specify below)
 PVC ABS Asbestos-Cement Concrete Tile

Blank casing diameter 2 in. Was casing pulled? Yes No If yes, how much Top 3 feet pulled
 Casing height above or below land surface 36 in.

6 GROUT PLUG MATERIAL: Neat cement Cement grout Bentonite Other _____

Grout Plug Intervals: From 24.6' ft. to 3' ft., From _____ ft. to _____ ft., From _____ ft. to _____ ft.

What is the nearest source of possible contamination:

- | | | | |
|---|---|---|---|
| <input type="checkbox"/> Septic tank | <input type="checkbox"/> Seepage pit | <input type="checkbox"/> Fuel storage | <input checked="" type="checkbox"/> Other (specify below)
NA |
| <input type="checkbox"/> Sewer lines | <input type="checkbox"/> Pit privy | <input type="checkbox"/> Fertilizer storage | |
| <input type="checkbox"/> Watertight sewer lines | <input type="checkbox"/> Sewage lagoon | <input type="checkbox"/> Insecticide storage | Direction from well? _____
How many feet? _____ |
| <input type="checkbox"/> Lateral lines | <input type="checkbox"/> Feedyard | <input type="checkbox"/> Abandoned water well | |
| <input type="checkbox"/> Cess pool | <input type="checkbox"/> Livestock pens | <input type="checkbox"/> Oil well/Gas well | |

FROM	TO	PLUGGING MATERIALS	FROM	TO	PLUGGING MATERIALS
24.6'	3'	Bentonite	3'	0'	Soil

7 CONTRACTOR'S OR LANDOWNER'S CERTIFICATION: This water well was plugged under my jurisdiction and was completed on (mo/day/year) 2/7/2019 and this record is true to the best of my knowledge and belief. Kansas Water Well Contractor's License No. 926. This Water Well Record was completed on (mo/day/year) 3/1/19 under the business name of Cascade by (signature) *[Signature]*

INSTRUCTIONS: Use typewriter or ballpoint pen. Please press firmly and print clearly. Please fill in blanks, underline or circle the correct answers. Send top three copies to Kansas Department of Health and Environment, Bureau of Water, Geology Section, 1000 SW Jackson St., Ste. 420, Topeka, Kansas 66612-1367. Telephone: 785/296-5524. Send one to Water Well Owner and retain one for your records. Visit us at <http://www.kdheks.gov/waterwell/index.html>.