

WATER WELL PLUGGING RECORD Form WWC-5P KSA 82a-1212 ID NO.


MW-1

1 **LOCATION OF WATER WELL:** County: Morton Fraction NW ¼ NE ¼ SE ¼ ¼ Section Number 29 Township Number T 34 S Range Number 43 E W

Street/Rural Address of Well Location; if unknown, distance & direction from nearest town or intersection: If at owner's address, check here
4 Miles North and 6.75 Miles West of Elkhart, Kansas

Global Positioning Systems (GPS) information:
Latitude: 37.060523302 (in decimal degrees)
Longitude: -102.011645064 (in decimal degrees)
Elevation: _____
Datum: WGS84, NAD83, NAD27
Collection Method:
 GPS unit (Make/Model: _____)
 Digital Map/Photo, Topographic Map, Land Survey
Est. Accuracy: < 3 m. 3-5 m. 5-15 m. > 15 m

2 **WATER WELL OWNER:** Anadarko Petroleum Company
RR#, St. Address, Box #: 1201 Lake Robbins Drive
City, State ZIP Code: The Woodlands, TX 77380

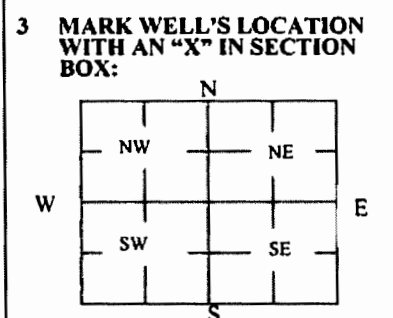

4 **DEPTH OF WELL** 47.7' ft.
WELL'S STATIC WATER LEVEL 34.8' ft
WELL WAS USED AS:
 Domestic Public Water Supply Dewatering
 Irrigation Oil Field Water Supply Monitoring
 Feedlot Domestic (Lawn & Garden) Injection Well
 Industrial Air Conditioning Other _____
Was a chemical/bacteriological sample submitted to Department? Yes No

5 **TYPE OF BLANK CASING USED:**
 Steel RMP (SR) Wrought Fiberglass Other (Specify below)
 PVC ABS Asbestos-Cement Concrete Tile
Blank casing diameter 2 in. Was casing pulled? Yes No If yes, how much Top 3 feet pulled
Casing height above or below land surface 36 in.

6 **GROUT PLUG MATERIAL:** Neat cement Cement grout Bentonite Other _____
Grout Plug Intervals: From 47.7' ft. to 3' ft., From _____ ft. to _____ ft., From _____ ft. to _____ ft.
What is the nearest source of possible contamination:
 Septic tank Seepage pit Fuel storage Other (specify below) NA
 Sewer lines Pit privy Fertilizer storage
 Watertight sewer lines Sewage lagoon Insecticide storage
 Lateral lines Feedyard Abandoned water well Direction from well? _____
 Cess pool Livestock pens Oil well/Gas well How many feet? _____

FROM	TO	PLUGGING MATERIALS	FROM	TO	PLUGGING MATERIALS
47.7'	3'	Bentonite	3'	0'	Soil

7 **CONTRACTOR'S OR LANDOWNER'S CERTIFICATION:** This water well was plugged under my jurisdiction and was completed on (mo/day/year) 2/5/2019 and this record is true to the best of my knowledge and belief. Kansas Water Well Contractor's License No. 9216. This Water Well Record was completed on (mo/day/year) 3/1/19 under the business name of Cascade by (signature) [Signature]

INSTRUCTIONS: Use typewriter or ballpoint pen. Please press firmly and print clearly. Please fill in blanks, underline or circle the correct answers. Send top three copies to Kansas Department of Health and Environment, Bureau of Water, Geology Section, 1000 SW Jackson St., Ste. 420, Topeka, Kansas 66612-1367. Telephone: 785/296-5524. Send one to Water Well Owner and retain one for your records. Visit us at <http://www.kdheks.gov/waterwell/index.html>.