


1 LOCATION OF WATER WELL: COUNTY: MORTON Fraction NE 1/4 NE 1/4 SW 1/4 Section Number 7 Township Number T 34 S Range Number R 43 W

Distance and direction from nearest town or city street address of well if located within city?
FROM BLKHART, KS - 9 W ON HIGHWAY 27, 7W, 2S, 1/2W AND 1/2 S

2 WATER WELL OWNER: MORTON CO. GRAZING ASSN. *Well # 2*
RR#, St. Address, Box #: BOX 121 Board of Agriculture, Division of Water Resources
City, State, ZIP code: BLKHART, KS 67950- Application Number:

3 LOCATE WELL'S LOCATION WITH AN "X" IN SECTION BOX: 4 DEPTH OF COMPLETED WELL 240 ELEVATION: 0
Depth(s) Groundwater Encountered 1. 0 ft. 2. 0 ft. 3. 0 ft.

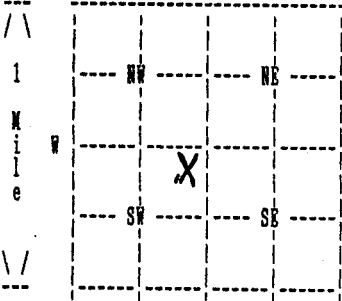

WELL'S STATIC WATER LEVEL 70 ft. below land surface measured on mo/day/yr 08/26/94
Pump test data: Well water was 0 ft. after 0 hours pumping 0 gpm
Estimated Yield 25 gpm: Well water was 0 ft. after 0 hours pumping 0 gpm
Bore Hole Diameter 9 in. to 240 ft., and in. to 0 ft.
WELL WATER TO BE USED AS: DOMESTIC
Was a chemical/bacteriological sample submitted to department? No ;
If yes, mo/day/yr sample was submitted Water well disinfected? Yes

5 TYPE OF CASING USED: PVC CASING JOINTS: GLUED
Blank casing diameter 5 in. to 240 ft., Dia in. to 0 ft., Dia in. to 0 ft.
Casing height above land surface 12 in., weight 200 lbs/ft. Wall thickness or gauge No. 21
TYPE OF SCREEN OR PERFORATION MATERIAL: PVC
SCREEN OR PERFORATION OPENINGS ARE: SAW CUT

SCREEN PERFORATED INTERVALS: From 195 ft. to 235 ft., From 0 ft. to 0 ft.
GRAVEL PACK INTERVALS: From 0 ft. to 0 ft., From 0 ft. to 0 ft.
From 20 ft. to 240 ft., From 0 ft. to 0 ft.
From 0 ft. to 0 ft., From 0 ft. to 0 ft.

6 GROUT MATERIAL BENTONITE
Grout intervals: From 0 ft. to 20 ft., From 0 ft. to 0 ft., From 0 ft. to 0 ft.
What is the nearest source of possible contamination: NONE - NEW SITE
Direction from well? How many feet? 0

FROM	TO	LITHOLOGIC LOG	FROM	TO	PLUGGING INTERVALS
0	10	TOPSOIL GRAY CALACHIE			
10	60	FINE SAND CLAY			
60	100	FINE SAND SANDY CLAY			
100	140	SAND GRAVEL			
140	190	MEDIUM SAND			
190	210	SAND CLAY			
210	240	SAND CLAY			
240	0	RED BED			

7 CONTRACTOR'S OR LANDOWNER'S CERTIFICATION: This water well was Constructed under my jurisdiction and was completed on (mo/day/year) 08/26/94 and this record is true to the best of my knowledge and belief. Kansas Water Well Contractor's License No. 179 This Water Well Record was completed on (mo/day/yr) 09/16/94 under the business name of JOB'S WELL SERVICE, INC. by (signature) *Justin Cist*