


1 LOCATION OF WATER WELL: Fraction NE 1/4 SE 1/4 Section Number 10 Township Number T 34 S Range Number R 6 E

Distance and direction from nearest town or city street address of well if located within city? 3 Miles East, #miles South, !mile ~~XXXXX~~ East, 1/2 Mile South Of Anthony, Kas.

2 WATER WELL OWNER: Don Hamill RR#, St. Address, Box #: 9509 West McArthur City, State, ZIP Code: Wichita, Kans. 67215 Board of Agriculture, Division of Water Resources Application Number:

3 LOCATE WELL'S LOCATION WITH AN "X" IN SECTION BOX:

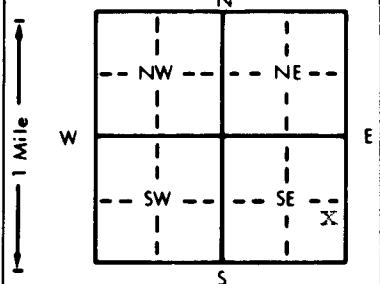

4 DEPTH OF COMPLETED WELL... 40' ft. ELEVATION: 13' 6" ft.

WELL'S STATIC WATER LEVEL 13' 6" ft. below land surface measured on mo/day/yr Jan. 6-1999. Pump test data: Well water was ... ft. after ... hours pumping ... gpm. Est. Yield .15 gpm: Well water was NA ... ft. after ... hours pumping ... gpm. Bore Hole Diameter 8 1/4" in. to 40' ft. and ... in. to ... ft. WELL WATER TO BE USED AS: 5 Public water supply 8 Air conditioning 11 Injection well 12 Other (Specify below) 2 Irrigation 4 Industrial 7 Lawn and garden only 10 Monitoring well Was a chemical/bacteriological sample submitted to Department? Yes No; If yes, mo/day/yr sample was submitted Water Well Disinfected? Yes No X

5 TYPE OF BLANK CASING USED: 1 Steel 3 RMP (SR) 2 PVC XX 4 ABS 5 Wrought iron 8 Concrete tile 6 Asbestos-Cement 9 Other (specify below) 7 Fiberglass CASING JOINTS: Glued XX Clamped Welded Threaded

Blank casing diameter 5" in. to 34' ft. Dia. 3.55 lbs./ft. Wall thickness or gauge No. 2.14

TYPE OF SCREEN OR PERFORATION MATERIAL: 1 Steel 3 Stainless steel 5 Fiberglass 8 RMP (SR) 2 Brass 4 Galvanized steel 6 Concrete tile 9 ABS 7 PVC XX 10 Asbestos-cement 11 Other (specify) 12 None used (open hole)

SCREEN OR PERFORATION OPENINGS ARE: 1 Continuous slot 3 Mill slot 5 Gauzed wrapped XX Saw cut 11 None (open hole) 2 Louvered shutter 4 Key punched 6 Wire wrapped 9 Drilled holes 7 Torch cut 10 Other (specify)

SCREEN-PERFORATED INTERVALS: From 40' ft. to 34' ft. GRAVEL PACK INTERVALS: From 40' ft. to 33' ft.

6 GROUT MATERIAL: 1 Neat cement 2 Cement grout XX Bentonite 4 Other Grout Intervals: From 33' ft. to 3' ft.

What is the nearest source of possible contamination: 1 Septic tank 4 Lateral lines 7 Pit privy 10 Livestock pens XX 14 Abandoned water well 2 Sewer lines 5 Cess pool 8 Sewage lagoon 11 Fuel storage 15 Oil well/Gas well 3 Watertight sewer lines 6 Seepage pit 9 Feedyard 12 Fertilizer storage 16 Other (specify below) 13 Insecticide storage

Direction from well? West How many feet? 75'

Table with columns: FROM, TO, LITHOLOGIC LOG, FROM, TO, PLUGGING INTERVALS. Rows include Top Soil, Clay, Fine Sand, Clay W/Sand & trips, Medium Fine Sand, Red Bed.

7 CONTRACTOR'S OR LANDOWNER'S CERTIFICATION: This water well was (1) constructed, (2) reconstructed, or (3) plugged under my jurisdiction and was completed on (mo/day/year) Jan. 6, 1999 and this record is true to the best of my knowledge and belief. Kansas Water Well Contractor's License No. 112 This Water Well Record was completed on (mo/day/yr) Jan. 15, 1999 under the business name of Wells Drilling Co. by (signature) Dal Wells

INSTRUCTIONS: Use typewriter or ball point pen. PLEASE PRESS FIRMLY and PRINT clearly. Please fill in blanks, underline or circle the correct answers. Send top three copies to Kansas Department of Health and Environment, Bureau of Water, Topeka, Kansas 66620-0001. Telephone: 913-296-5545. Send one to WATER WELL OWNER and retain one for your records.

OFFICE USE ONLY T R E/W SEC. 1/4 1/4 1/4