


1 LOCATION OF WATER WELL: County: Barber Fraction: NW 1/4 NW 1/4 SW 1/4 Section Number: 11 Township Number: T 35 S Range Number: R 11 E

Distance and direction from nearest town or city street address of well if located within city? 400 Main, Kiowa, KS

2 WATER WELL OWNER: D&B Stores RR#: 400 Main City, State, ZIP Code: Kiowa, KS 67070 Board of Agriculture, Division of Water Resources Application Number:

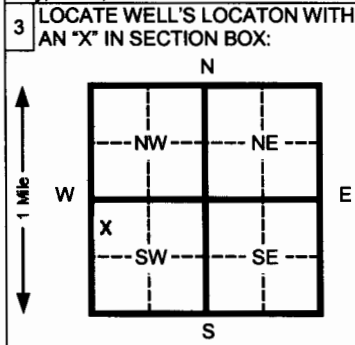

3 LOCATE WELL'S LOCATION WITH AN 'X' IN SECTION BOX: 4 DEPTH OF COMPLETED WELL: 20.0 ft. ELEVATION: 1328.07. Includes pump test data, yield (NA), and casing details.

5 TYPE OF BLANK CASING USED: 1 Steel, 2 PVC, 3 RMP (SR), 4 ABS. Includes blank casing diameter (2.375 in.) and weight (Flush Mount).

SCREEN OR PERFORATION MATERIAL: 1 Steel, 2 Brass, 3 Mill slot, 4 Key punched, 5 Fiberglass, 6 Concrete tile, 7 Torch cut, 8 RMP (SR), 9 ABS, 10 Asbestos-cement, 11 Other (specify).

6 GROUT MATERIAL: 1 Neat cement, 2 Cement grout, 3 Bentonite, 4 Other. Includes grout intervals and nearest source of contamination.

LITHOLOGIC LOG table with columns FROM, TO, CODE and descriptions: Gravel and sand, Dark brown clay, Red brown clay, Red clay, Sandy Red Brown clay.

7 CONTRACTOR'S OR LANDOWNER'S CERTIFICATION: This water well was constructed on 05/21/08 and this record is true to the best of my knowledge and belief. Completed on 06/10/08.

INSTRUCTIONS: Please fill in blanks and circle the correct answers. Send three copies to Kansas Department of Health and Environment, Bureau of Water, 1000 S.W. Jackson St., Ste. 420, Topeka, Kansas 66612-1367.