

WATER WELL RECORD


Form WWC-5

Division of Water Resources App. No.

1 LOCATION OF WATER WELL: County: Barber, Fraction: 1/4 NW 1/4 SE 1/4 SW 1/4, Section Number: 5, Township No. T 35 S, Range Number R 11 E W

Street/Rural Address of Well Location: 3 West of Kiowa, Global Positioning System (GPS) information: Latitude, Longitude, Elevation, Datum, Collection Method

2 WATER WELL OWNER: Fresh water LLC, RR#, Street Address, Box #: P.O. Box 209, City, State, ZIP Code: Medicine Lodge, KS 67104

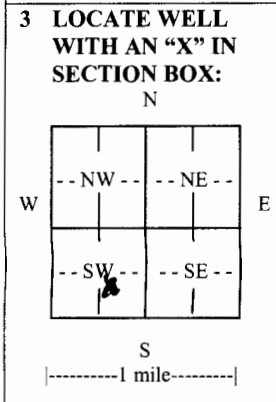

3 LOCATE WELL WITH AN 'X' IN SECTION BOX: N, W, E, S, 4 DEPTH OF COMPLETED WELL: 52 ft, Depth(s) Groundwater Encountered, WELL'S STATIC WATER LEVEL: 24 1/2 ft, Pump test data, EST. YIELD: 60 gpm, Bore Hole Diameter: 10 in, WELL WATER TO BE USED AS: Industrial, Was a chemical/bacteriological sample submitted, Water well disinfected?

5 TYPE OF CASING USED: PVC, CASING JOINTS: Glued, Clamped, Welded, Threaded, Casing diameter: 6 in, Casing height above land surface: 24 in, TYPE OF SCREEN OR PERFORATION MATERIAL: PVC, SCREEN OR PERFORATION OPENINGS ARE: Saw cut, SCREEN-PERFORATED INTERVALS: 42 ft to 52 ft, GRAVEL PACK INTERVALS: 23 ft to 52 ft

6 GROUT MATERIAL: Bentonite, Grout Intervals: 3 ft to 23 ft, What is the nearest source of possible contamination: Oil well/gas well, Direction from well: W, Distance from well: 1320

Table with columns FROM, TO, LITHOLOGIC LOG, FROM, TO, LITHO. LOG (cont.) or PLUGGING INTERVALS. Rows describe soil layers from 0 to 52 feet depth.

7 CONTRACTOR'S OR LANDOWNER'S CERTIFICATION: This water well was constructed, reconstructed, or plugged under my jurisdiction and was completed on (mo/day/year) 5-22-12... Kansas Water Well Contractor's License No. 140... This Water Well Record was completed on (mo/day/year) 5-22-12... under the business name of Lyman's Inc by (signature) Lyman's Inc

INSTRUCTIONS: Use typewriter or ball point pen. PLEASE PRESS FIRMLY and PRINT clearly. Please fill in blanks and check the correct answers. Send three copies (white, blue, pink) to Kansas Department of Health and Environment, Bureau of Water, Geology Section, 1000 SW Jackson St., Suite 420 Topeka, Kansas 66612-1367. Telephone 785-296-5524. Send one copy to WATER WELL OWNER and retain one for your records. Include fee of \$5.00 for each constructed well. Visit us at http://www.kdheks.gov/waterwell/index.html.