


MW-6 2011049

1 LOCATION OF WATER WELL: Fraction NW 1/4 SW 1/4 NE 1/4 Section Number 11 Township Number T 35 S Range Number R 11 EW  
 County: Barber

Distance and direction from nearest town or city street address of well if located within city?  
700 Main Street

2 WATER WELL OWNER: D & B Stores, Inc. Board of Agriculture, Division of Water Resources  
 RR#, St. Address, Box #: 700 Main St. Application Number:  
 City, State, ZIP Code: Nowa, KS, 67070

3 LOCATE WELL'S LOCATION WITH AN "X" IN SECTION BOX:

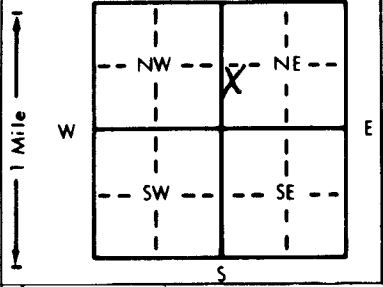

4 DEPTH OF COMPLETED WELL: 16 ft. ELEVATION:  
 Depth(s) Groundwater Encountered 1. 11.5 ft. 2. ft. 3. ft.  
 WELL'S STATIC WATER LEVEL: 12.03 ft. below land surface measured on mo/day/yr 3-15-93

Pump test data: Well water was ft. after hours pumping gpm  
 Est. Yield gpm; Well water was ft. after hours pumping gpm  
 Bore Hole Diameter: 8 in. to ft., and in. to ft.

WELL WATER TO BE USED AS:  
 5 Public water supply 8 Air conditioning 11 Injection well  
 1 Domestic 3 Feedlot 6 Oil field water supply 9 Dewatering 12 Other (Specify below)  
 2 Irrigation 4 Industrial 7 Lawn and garden only 10 Monitoring well

Was a chemical/bacteriological sample submitted to Department? Yes.....No X.....; If yes, mo/day/yr sample was submitted  
 Water Well Disinfected? Yes No X

5 TYPE OF BLANK CASING USED:  
 1 Steel PVC 3 RMP (SR) 4 ABS 5 Wrought iron 8 Concrete tile 9 Other (specify below)  
 6 Asbestos-Cement 7 Fiberglass 10 Asbestos-cement 11 Other (specify) 12 None used (open hole)

Blank casing diameter: 2 in. to ft., Dia. in. to ft., Dia. in. to ft.  
 Casing height above land surface: Flush in., weight: 70.3 lbs./ft. Wall thickness or gauge No. 154  
 TYPE OF SCREEN OR PERFORATION MATERIAL: 7 PVC 10 Asbestos-cement 11 Other (specify) 12 None used (open hole)

SCREEN OR PERFORATION OPENINGS ARE:  
 1 Continuous slot 2 Louvered shutter 3 Mill slot 4 Key punched 5 Gauzed wrapped 6 Wire wrapped 7 Torch cut 8 Saw cut 9 Drilled holes 10 Other (specify) 11 None (open hole)

SCREEN-PERFORATED INTERVALS: From 6 ft. to 16 ft., From ft. to ft.  
 From ft. to ft., From ft. to ft.  
 GRAVEL PACK INTERVALS: From 5 ft. to 16 ft., From ft. to ft.  
 From ft. to ft., From ft. to ft.

6 GROUT MATERIAL: 1 Neat cement 2 Cement grout 3 Bentonite 4 Other  
 Grout Intervals: From 5 ft. to 1 ft., From ft. to ft., From ft. to ft.  
 What is the nearest source of possible contamination:  
 1 Septic tank 4 Lateral lines 7 Pit privy 11 Fuel storage 14 Abandoned water well  
 2 Sewer lines 5 Cess pool 8 Sewage lagoon 12 Fertilizer storage 15 Oil well/Gas well  
 3 Watertight sewer lines 6 Seepage pit 9 Feedyard 13 Insecticide storage 16 Other (specify below)

Direction from well? S How many feet? 300

FROM	TO	LITHOLOGIC LOG	FROM	TO	PLUGGING INTERVALS
0.0	6.0	Clay, brown, silty			
6.0	16.0	Silt, sandy			

Flush mount waiver granted 12-17-93  
 for D & B Stores, Inc.; KDHE 01004604  
 by Don Taylor

7 CONTRACTOR'S OR LANDOWNER'S CERTIFICATION: This water well was (1) constructed (2) reconstructed, or (3) plugged under my jurisdiction and was completed on (mo/day/year) 3-15-93 and this record is true to the best of my knowledge and belief. Kansas Water Well Contractor's License No. 531 This Water Well Record was completed on (mo/day/yr) 3-17-93 under the business name of GSI by (signature) Allison Arwin

OFFICE USE ONLY  
T  
R  
EW  
SEC.