


1 LOCATION OF WATER WELL: County: **BARBER** Fraction: **SW 1/4 SE 1/4 NE 1/4** Section Number: **14** Township Number: **T 35 S** Range Number: **R 12 E/W**

Distance and direction from nearest town or city street address of well if located within city?  
**Hutchinson**

2 WATER WELL OWNER: **Albert Harold & Dona Mae Gottsch**  
 RR#, St. Address, Box #: **4105 N. MONROE** Board of Agriculture, Division of Water Resources  
 City, State, ZIP Code: **Hutchinson KS 67502** Application Number:

3 LOCATE WELL'S LOCATION WITH AN "X" IN SECTION BOX: 4 DEPTH OF COMPLETED WELL: **145** ft. ELEVATION:

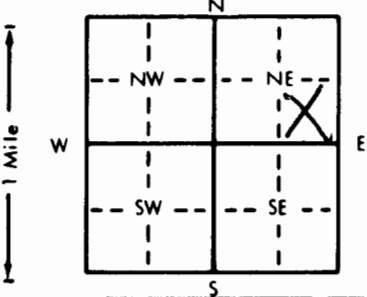

Depth(s) Groundwater Encountered 1. **118** ft. 2. ft. 3. ft.  
 WELL'S STATIC WATER LEVEL **27** ft. below land surface measured on mo/day/yr **4/12/91**  
 Pump test data: Well water was ft. after hours pumping gpm  
 Est. Yield gpm: Well water was ft. after hours pumping gpm  
 Bore Hole Diameter in. to ft. and in. to ft.  
 WELL WATER TO BE USED AS: 5 Public water supply 8 Air conditioning 11 Injection well  
 1 Domestic 3 Feedlot 6 Oil field water supply 9 Dewatering 12 Other (Specify below)  
 2 Irrigation 4 Industrial 7 Lawn and garden only 10 Monitoring well  
 Was a chemical/bacteriological sample submitted to Department? Yes No  If yes, mo/day/yr sample was submitted  
 Water Well Disinfected? Yes No

5 TYPE OF BLANK CASING USED: 5 Wrought iron 8 Concrete tile CASING JOINTS: Glued Clamped  
 1 Steel 3 RMP (SR) 6 Asbestos-Cement 9 Other (specify below) Welded  
 2 PVC 4 ABS 7 Fiberglass Threaded

Blank casing diameter **5** in. to ft., Dia. in. to ft., Dia. in. to ft.  
 Casing height above land surface: **36" Below** in., weight lbs./ft. Wall thickness or gauge No.

TYPE OF SCREEN OR PERFORATION MATERIAL: 7 PVC 10 Asbestos-cement  
 1 Steel 3 Stainless steel 5 Fiberglass 8 RMP (SR) 11 Other (specify) **NA**  
 2 Brass 4 Galvanized steel 6 Concrete tile 9 ABS 12 None used (open hole)

SCREEN OR PERFORATION OPENINGS ARE: 5 Gauzed wrapped 8 Saw cut 11 None (open hole)  
 1 Continuous slot 3 Mill slot 6 Wire wrapped 9 Drilled holes  
 2 Louvered shutter 4 Key punched 7 Torch cut 10 Other (specify) **NA**

SCREEN-PERFORATED INTERVALS: From ft. to ft., From ft. to ft., From ft. to ft.  
 GRAVEL PACK INTERVALS: From ft. to ft., From ft. to ft., From ft. to ft.

6 GROUT MATERIAL: 1 Neat cement 2 Cement grout 3 Bentonite 4 Other  
 Grout intervals: From **5** ft. to **8** ft., From ft. to ft., From ft. to ft.

What is the nearest source of possible contamination: 10 Livestock pens 14 Abandoned water well  
 1 Septic tank 4 Lateral lines 7 Pit privy 11 Fuel storage 15 Oil well/Gas well  
 2 Sewer lines 5 Cess pool 8 Sewage lagoon 12 Fertilizer storage 16 Other (specify below)  
 3 Watertight sewer lines 6 Seepage pit 9 Feedyard 13 Insecticide storage **DONE**

Direction from well? How many feet?

FROM	TO	LITHOLOGIC LOG	FROM	TO	PLUGGING INTERVALS
			<b>145</b>	<b>8</b>	<b>Well Pit 5 ft Deep</b>
			<b>8</b>	<b>5</b>	<b>SAND</b>
			<b>5</b>	<b>0</b>	<b>BENTONITE</b>
					<b>SURFACE CLAY (This will be</b>
					<b>DONE AS SOON AS WALLS OF</b>
					<b>PIT CAN BE REMOVED)</b>

7 CONTRACTOR'S OR LANDOWNER'S CERTIFICATION: This water well was (1) constructed, (2) reconstructed, or (3) plugged under my jurisdiction and was completed on (mo/day/year) **4/12/91** and this record is true to the best of my knowledge and belief. Kansas Water Well Contractor's License No. This Water Well Record was completed on (mo/day/yr) under the business name of by signature **A. Harold Gottsch**

OFFICE USE ONLY