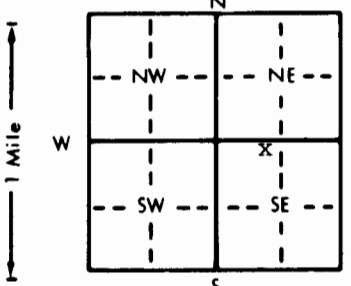


1 LOCATION OF WATER WELL: County: Barber 004 Fraction: NE $\frac{1}{4}$ NW $\frac{1}{4}$ SE $\frac{1}{4}$ Section Number: 8 Township Number: T 35 S Range Number: R 12 EW

Distance and direction from nearest town or city street address of well if located within city?
 209 East Central, Hardtner, KS Well # PW-1

2 WATER WELL OWNER: R. T. Grant Oil and Builders Supply
 RR#, St. Address, Box #: 209 East Central Board of Agriculture, Division of Water Resources
 City, State, ZIP Code: Hartner, KS Application Number:

3 LOCATE WELL'S LOCATION WITH AN "X" IN SECTION BOX:

 4 DEPTH OF COMPLETED WELL: 50 ft. ELEVATION: 1424.65
 Depth(s) Groundwater Encountered: 1. 40 ft. 2. ft. 3. ft.
 WELL'S STATIC WATER LEVEL: 40 ft. below land surface measured on mo/day/yr 6/21/94
 Pump test data: Well water was ft. after hours pumping gpm
 Est. Yield gpm: Well water was ft. after hours pumping gpm
 Bore Hole Diameter: 8 in. to 50 ft., and in. to ft.
 WELL WATER TO BE USED AS:
 5 Public water supply 8 Air conditioning 11 Injection well
 1 Domestic 3 Feedlot 6 Oil field water supply 9 Dewatering 12 Other (Specify below)
 2 Irrigation 4 Industrial 7 Lawn and garden only 10 Monitoring well
 Was a chemical/bacteriological sample submitted to Department? Yes NO; If yes, mo/day/yr sample was submitted
 Water Well Disinfected? Yes No

5 TYPE OF BLANK CASING USED:
 1 Steel 3 RMP (SR) 5 Wrought iron 8 Concrete tile CASING JOINTS: Glued Clamped
 2 PVC 4 ABS 6 Asbestos-Cement 9 Other (specify below) Welded
 7 Fiberglass Threaded
 Blank casing diameter: 4 in. to 50 ft., Dia. in. to ft., Dia. in. to ft.
 Casing height above land surface: -6 in., weight lbs./ft. Wall thickness or gauge No. Schedule 40
 TYPE OF SCREEN OR PERFORATION MATERIAL:
 1 Steel 3 Stainless steel 5 Fiberglass 8 RMP (SR) 10 Asbestos-cement
 2 Brass 4 Galvanized steel 6 Concrete tile 9 ABS 12 None used (open hole)
 SCREEN OR PERFORATION OPENINGS ARE:
 1 Continuous slot 3 Mill slot 5 Gauzed wrapped 8 Saw cut 11 None (open hole)
 2 Louvered shutter 4 Key punched 6 Wire wrapped 9 Drilled holes
 7 Torch cut 10 Other (specify)
 SCREEN-PERFORATED INTERVALS: From 20 ft. to 50 ft., From ft. to ft.
 GRAVEL PACK INTERVALS: From 20 ft. to 50 ft., From ft. to ft.
 From ft. to ft., From ft. to ft.

6 GROUT MATERIAL: 1 Neat cement 2 Cement grout 3 Bentonite 4 Other
 Grout Intervals: From 2 ft. to 20 ft., From ft. to ft., From ft. to ft.
 What is the nearest source of possible contamination:
 1 Septic tank 4 Lateral lines 7 Pit privy 10 Livestock pens 14 Abandoned water well
 2 Sewer lines 5 Cess pool 8 Sewage lagoon 11 Fuel storage 15 Oil well/Gas well
 3 Watertight sewer lines 6 Seepage pit 9 Feedyard 12 Fertilizer storage 16 Other (specify below)
 former gasoline UST
 13 Insecticide storage How many feet?

Direction from well?		LITHOLOGIC LOG		PLUGGING INTERVALS	
FROM	TO	FROM	TO	FROM	TO
0	2				
2	10		reddish brown fill loam		
			red silty clay		
10	12		red silty clay, medium fat		
12	50		red silty clay		

7 CONTRACTOR'S OR LANDOWNER'S CERTIFICATION: This water well was (1) constructed, (2) reconstructed, or (3) plugged under my jurisdiction and was completed on (mo/day/year) 6/21/94 and this record is true to the best of my knowledge and belief. Kansas Water Well Contractor's License No. 534 This Water Well Record was completed on (mo/day/yr) 2/1/95 under the business name of PSI by (signature) Neil Ad

OFFICE USE ONLY
T
R
EW
SEC.