

MW-18

WATER WELL RECORD

Form WWC-5

Division of Water Resources App. No.


Empty box for application number

1 LOCATION OF WATER WELL: County: Barber, Fraction: 1/4 NW 1/4 NW 1/4 SW 1/4, Section Number: 28, Township No. T 35 S, Range Number R 15

Street/Rural Address of Well Location; if unknown, distance & direction from nearest town or intersection: Site is located along Aetna Rd. approximately 14 miles south of Aetna Rd. and Hwy 160.

2 WATER WELL OWNER: ConocoPhillips, RR#, Street Address, Box #: 1614-02 Phillips Bldg., City, State, ZIP Code: Bartlesville, OK 74004

Global Positioning System (GPS) information: Latitude, Longitude, Elevation, Datum, Collection Method: GPS unit (Garmin 60C)

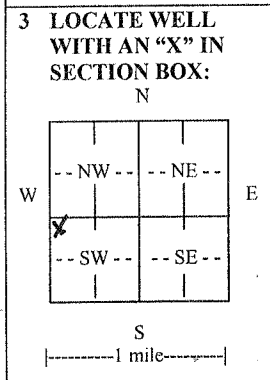

4 DEPTH OF COMPLETED WELL: 25 ft. Depth(s) Groundwater Encountered, WELL'S STATIC WATER LEVEL, Pump test data, EST. YIELD, Bore Hole Diameter, WELL WATER TO BE USED AS: Monitoring well

5 TYPE OF CASING USED: PVC, CASING JOINTS: Threaded, Casing diameter, Casing height above land surface, TYPE OF SCREEN OR PERFORATION MATERIAL: PVC, SCREEN OR PERFORATION OPENINGS ARE: Mill slot, SCREEN-PERFORATED INTERVALS, GRAVEL PACK INTERVALS

6 GROUT MATERIAL: Bentonite, Grout Intervals, What is the nearest source of possible contamination: Fuel storage

Table with 6 columns: FROM, TO, LITHOLOGIC LOG, FROM, TO, LITHO. LOG (cont.) or PLUGGING INTERVALS. Row 1: 25, 0, Silt and Very Fine Sand w/Gypsum

7 CONTRACTOR'S OR LANDOWNER'S CERTIFICATION: This water well was constructed, reconstructed, or plugged under my jurisdiction and was completed on (mo/day/year) 11-16-11

INSTRUCTIONS: Use typewriter or ball point pen. PLEASE PRESS FIRMLY and PRINT clearly. Please fill in blanks and check the correct answers.