


1	LOCATION OF WATER WELL:	Fraction	Section Number	Township Number	Range Number
	County: <u>Clark</u>	<u>NW 1/4 NW 1/4 NE 1/4</u>	<u>12</u>	<u>35</u>	<u>023</u> E/W

Distance and direction from nearest town or city street address of well if located within city?

2 WATER WELL OWNER: DONALD G PAINTER  
 RR #, St. Address, Box #: 3625 Cheyenne Dr  
 City, State, ZIP Code: Woodward, OK 73801  
 Board of Agriculture, Division of Water Resources  
 Application Number: \_\_\_\_\_

3	MARK WELL'S LOCATION WITH AN "X" IN SECTION BOX:	4	DEPTH OF WELL ..... <u>30</u> ..... ft. WELL'S STATIC WATER LEVEL ..... <u>20</u> ..... ft. WELL WAS USED AS: 1 Domestic 2 Irrigation 3 Feedlot 4 Industrial 5 Public Water Supply 6 Oil Field Water Supply 7 Domestic (Lawn & Garden) 8 Air Conditioning 9 Dewatering 10 Monitoring Well 11 Injection Well 12 Other <u>Livestock</u>
---	--	---	---

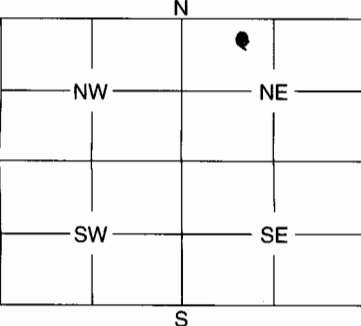

Was a chemical / bacteriological sample submitted to Department? Yes ..... No X.....  
 If yes, mo/day/yr sample was submitted .....

Water Well Disinfected: Yes X No .....

5 TYPE OF BLANK CASING USED:

1 Steel	3 RMP (SR)	5 Wrought	7 Fiberglass	9 Other (Specify below)
2 PVC	4 ABS	6 Asbestos-Cement	8 Concrete Tile	

Blank casing diameter ..... 5 ..... in.  
 Casing height above or below land surface ..... 30 ..... in.

Was casing pulled? Yes ..... No X..... If yes, how much .....

6 GROUT PLUG MATERIAL: 1 Neat cement 2 Cement grout 3 Bentonite 4 Other .....

Grout Plug Intervals: From 30 ft. to 20 ft., From 10 ft. to 6 ft., From 6' to 3' ft.

What is the nearest source of possible contamination: top Soil 3' to Surface

1 Septic tank	6 Seepage pit	11 Fuel storage	16 Other (specify below)
2 Sewer lines	7 Pit privy	12 Fertilizer storage	
3 Watertight sewer lines	8 Sewage lagoon	13 Insecticide storage	
4 Lateral lines	9 Feedyard	14 Abandoned water well	
5 Cess pool	10 Livestock pens	15 Oil well/Gas well	

Direction from well? ..... How many feet? .....

FROM	TO	PLUGGING MATERIALS
		<u>Chlorine</u>
<u>30'</u>	<u>10'</u>	<u>Sand</u>
<u>10'</u>	<u>6'</u>	<u>Subsoil</u>
<u>6'</u>	<u>3'</u>	<u>Quartz crete - Cement</u>
<u>3'</u>	<u>0</u>	<u>TOP SOIL</u>

7 CONTRACTOR'S OF LANDOWNER'S CERTIFICATION: This water well was plugged under my jurisdiction and was completed on (mo/day/year) Oct 23, 2005 and this record is true to the best of my knowledge and belief. Kansas Water Well Contractor's License No. .... This Water Well Record was completed on (mo/day/year) ..... under the business name of .....  
 by (signature) Donald G Painter

INSTRUCTIONS: Use typewriter or ball point pen. Please press firmly and print clearly. Please fill in blanks, underline or circle the correct answers. Send top three copies to Kansas Department of Health and Environment, Bureau of Water, Geology Section, 1000 SW Jackson St., Ste. 420, Topeka, Kansas 66612-1367. Telephone: 785/296-5522. Send one to Water Well Owner and retain one for your records.