


MW7

1 LOCATION OF WATER WELL: Fraction SW 1/4 NW 1/4 NE 1/4 Section Number 1 Township Number T 35 S Range Number R 25 EW
 County: Clark

Distance and direction from nearest town or city street address of well if located within city?
Near 4th and Elm Englewood KS

2 WATER WELL OWNER: Jenny's Service Board of Agriculture, Division of Water Resources
 RR#, St. Address, Box #: PO Box 75 Application Number:
 City, State, ZIP Code: Englewood KS 67840

3 LOCATE WELL'S LOCATION WITH AN "X" IN SECTION BOX:

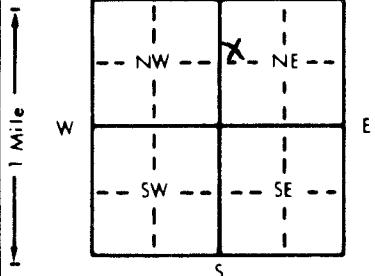

4 DEPTH OF COMPLETED WELL: 21.5 ft. ELEVATION: 1968.08
 Depth(s) Groundwater Encountered 1. 1.7 ft. 2. _____ ft. 3. _____ ft.
 WELL'S STATIC WATER LEVEL: 15.48 ft. below land surface measured on mo/day/yr
 Pump test data: Well water was _____ ft. after _____ hours pumping _____ gpm
 Est. Yield _____ gpm; Well water was _____ ft. after _____ hours pumping _____ gpm
 Bore Hole Diameter: 8 1/4 in. to 22.0 in. to _____ in. to _____ in.
 WELL WATER TO BE USED AS:
 5 Public water supply 8 Air conditioning 11 Injection well
 1 Domestic 3 Feedlot 6 Oil field water supply 9 Dewatering 12 Other (Specify below)
 2 Irrigation 4 Industrial 7 Lawn and garden only 10 Monitoring well
 Was a chemical/bacteriological sample submitted to Department? Yes _____ No _____; If yes, mo/day/yr sample was submitted _____
 Water Well Disinfected? Yes 10

5 TYPE OF BLANK CASING USED:
 1 Steel 3 RMP (SR) 5 Wrought iron 8 Concrete tile CASING JOINTS: Glued _____ Clamped _____
2 PVC 4 ABS 7 Fiberglass 9 Other (specify below) Welded _____ Threaded ✓

Blank casing diameter: 2 in. to 11.5 ft. Dia _____ in. to _____ ft. Dia _____ in. to _____ ft.
 Casing height above land surface: -4.5 in., weight _____ lbs./ft. Wall thickness or gauge No. Sch 40

TYPE OF SCREEN OR PERFORATION MATERIAL:
 1 Steel 3 Stainless steel 5 Fiberglass 8 RMP (SR) 10 Asbestos-cement
 2 Brass 4 Galvanized steel 6 Concrete tile 9 ABS 11 Other (specify) _____
 12 None used (open hole)

SCREEN OR PERFORATION OPENINGS ARE:
 1 Continuous slot 3 Mill slot 5 Gauzed wrapped 8 Saw cut 11 None (open hole)
 2 Louvered shutter 4 Key punched 6 Wire wrapped 9 Drilled holes
 7 Torch cut 10 Other (specify) _____

SCREEN-PERFORATED INTERVALS: From 11.5 ft. to 21.5 ft. From _____ ft. to _____ ft.
 From _____ ft. to _____ ft. From _____ ft. to _____ ft.
 GRAVEL PACK INTERVALS: From 9.5 ft. to 22.0 ft. From _____ ft. to _____ ft.
 From _____ ft. to _____ ft. From _____ ft. to _____ ft.

6 GROUT MATERIAL: 1 Neat cement 2 3 Cement grout 3 Bentonite 4 Other _____
 Grout Intervals: From 0 ft. to 7.5 ft. From 7.5 ft. to 9.5 ft. From _____ ft. to _____ ft.

What is the nearest source of possible contamination:
 1 Septic tank 4 Lateral lines 7 Pit privy 11 Fuel storage 14 Abandoned water well
 2 Sewer lines 5 Cess pool 8 Sewage lagoon 12 Fertilizer storage 15 Oil well/Gas well
 3 Watertight sewer lines 6 Seepage pit 9 Feedyard 13 Insecticide storage 16 Other (specify below)

Direction from well? Southwest How many feet? 325

FROM	TO	LITHOLOGIC LOG	FROM	TO	PLUGGING INTERVALS
0	4	Silty Clay			
4	13	Silty Clay with Gravel			
13	18	Medium Sand			
18	22	Coarse Sand			

7 CONTRACTOR'S OR LANDOWNER'S CERTIFICATION. This water well was 1 constructed, (2) reconstructed, or (3) plugged under my jurisdiction and was completed on (mo/day/year) 3-10-94 and this record is true to the best of my knowledge and belief. Kansas Water Well Contractor's License No. 829 This Water Well Record was completed on (mo/day/yr) 4-1-94 under the business name of Geotechnology, Inc by (signature) AT Balaban

OFFICE USE ONLY T R EW SEC. 1/4 1/4 1/4