

|                           |                             |                |                 |                         |
|---------------------------|-----------------------------|----------------|-----------------|-------------------------|
| 1 LOCATION OF WATER WELL: | Fraction                    | Section Number | Township Number | Range Number            |
| County: <u>Meade</u>      | <u>NW 1/4 NW 1/4 SW 1/4</u> | <u>2</u>       | T <u>35</u> S   | R <u>26</u> E <u>10</u> |

Distance and direction from nearest town or city street address of well if located within city?

7 1/2 W and 1/2 mi South of Englewood2 WATER WELL OWNER: Chris Smith

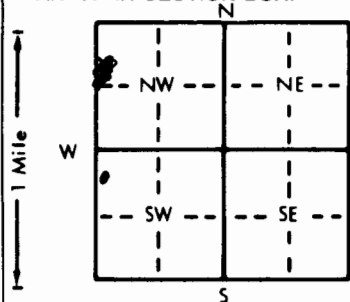
RR#, St. Address, Box # :

City, State, ZIP Code : Meade, KS 67864

Board of Agriculture, Division of Water Resources

Application Number:

3 LOCATE WELL'S LOCATION WITH AN "X" IN SECTION BOX:

4 DEPTH OF COMPLETED WELL: 103 ft. ELEVATION:

Depth(s) Groundwater Encountered 1. . . . . ft. 2. . . . . ft. 3. . . . . ft.

WELL'S STATIC WATER LEVEL: 45 ft. below land surface measured on mo/day/yr 7-1-93

Pump test data: Well water was . . . . . ft. after . . . . . hours pumping . . . . . gpm

Est. Yield 4 gpm. Well water was 95 ft. after 1 hours pumping 5 gpmBore Hole Diameter: 8 3/4 in. to . . . . . ft., and . . . . . in. to . . . . . ft.

WELL WATER TO BE USED AS:

☒ Domestic      3 Feedlot      6 Oil field water supply      9 Dewatering      12 Other (Specify below)

☐ 2 Irrigation      4 Industrial      7 Lawn and garden only      10 Monitoring well
Was a chemical/bacteriological sample submitted to Department? Yes . . . . . No ☒; If yes, mo/day/yr sample was sub-

mitted

Water Well Disinfected? Yes ☒ No

5 TYPE OF BLANK CASING USED:

☒ 1 Steel      3 RMP (SR)      5 Wrought iron      8 Concrete tile      CASING JOINTS: Glued ☒ Clamped . . . . .

☒ 2 PVC      4 ABS      6 Asbestos-Cement      9 Other (specify below)      Welded . . . . .

☐ 3 Fiberglass      Threaded. . . . .
Blank casing diameter 5 in. to 63 ft., Dia. . . . . in. to . . . . . ft., Dia. . . . . in. to . . . . . ft.Casing height above land surface 24 in., weight . . . . . lbs./ft. Wall thickness or gauge No. 20016

TYPE OF SCREEN OR PERFORATION MATERIAL:

☒ 1 Steel      3 Stainless steel      5 Fiberglass      8 RMP (SR)      10 Asbestos-cement

☐ 2 Brass      4 Galvanized steel      6 Concrete tile      9 ABS      11 Other (specify) . . . . .

☐ 12 None used (open hole)

SCREEN OR PERFORATION OPENINGS ARE:

☐ 1 Continuous slot      3 Mill slot      5 Gauzed wrapped      8 Saw cut      11 None (open hole)

☐ 2 Louvered shutter      4 Key punched      6 Wire wrapped      9 Drilled holes

☐ 7 Torch cut      10 Other (specify) . . . . .
SCREEN-PERFORATED INTERVALS: From 63 ft. to 103 ft., From . . . . . ft. to . . . . . ft.

From . . . . . ft. to . . . . . ft., From . . . . . ft. to . . . . . ft.

GRAVEL PACK INTERVALS: From 20 ft. to 103 ft., From . . . . . ft. to . . . . . ft.

From . . . . . ft. to . . . . . ft., From . . . . . ft. to . . . . . ft.

6 GROUT MATERIAL: ☒ 1 Neat cement      ☒ 2 Cement grout      3 Bentonite      4 Other . . . . .Grout Intervals: From top ft. to 20 ft., From . . . . . ft. to . . . . . ft., From . . . . . ft. to . . . . . ft.

What is the nearest source of possible contamination:

☐ 1 Septic tank      4 Lateral lines      7 Pit privy      10 Livestock pens      14 Abandoned water well

☐ 2 Sewer lines      ☒ 5 Cess pool      8 Sewage lagoon      11 Fuel storage      15 Oil well/Gas well

☐ 3 Watertight sewer lines      6 Seepage pit      9 Feedyard      12 Fertilizer storage      16 Other (specify below)

☐ 13 Insecticide storage
Direction from well? SE How many feet? 2000

FROM TO LITHOLOGIC LOG FROM TO PLUGGING INTERVALS

0 10 topsoil
10 25 brown clay
25 35 sand
35 50 sandy brown clay
50 70 sand
70 103 red bed
7 CONTRACTOR'S OR LANDOWNER'S CERTIFICATION: This water well was ☒ (1) constructed, (2) reconstructed, or (3) plugged under my jurisdiction and was completed on (mo/day/year) 7-1-93 and this record is true to the best of my knowledge and belief. KansasWater Well Contractor's License No. 101 This Water Well Record was completed on (mo/day/yr) 7-28-93under the business name of Bartel Well Drilling, Inc by (signature) Ruben J. Bartel