

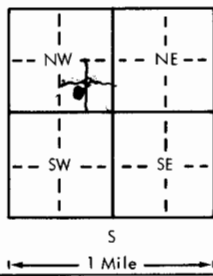
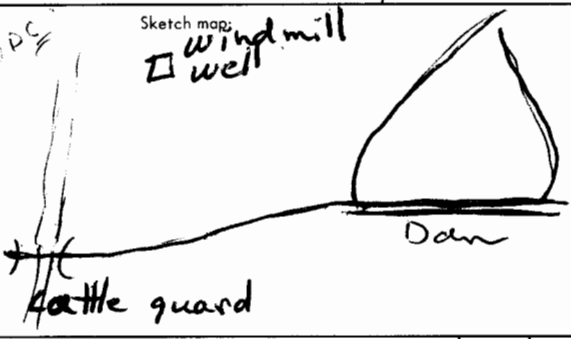
USE TYPEWRITER OR BALL
POINT PEN-PRESS FIRMLY,
PRINT CLEARLY.

based on sketch below and
Topo, location should be

12 BDB - Ext. Flw
is 2300' I

WATER WELL RECORD
KSA 82a-1201-1215

Kansas Department of Health and
Environment-Division of Environment
(Water well Contractors)
Topeka, Kansas 66620

1. Location of well:		County Meade	Fraction NE 1/4 SE 1/4 NE 1/4	Section number 12	Township number T 35 S R 27 E 10	Range number
2. Distance and direction from nearest town or city: Street address of well location if in city:		3. Owner of well: Dick Fincham R.R. or street: Englewood Rte. City, state, zip code: Meade, Kansas 67864				
4. Locate with "X" in section below: 		Sketch map: 		6. Bore hole dia. 8 1/2 in. Completion date 4-27-79 Well depth 234 ft.		
5. Type and color of material		From	To	7. Cable tool <input checked="" type="checkbox"/> Rotary <input type="checkbox"/> Driven <input type="checkbox"/> Dug <input type="checkbox"/> Hollow rod <input type="checkbox"/> Jetted <input type="checkbox"/> Bored <input type="checkbox"/> Reverse rotary		
topsoil		0	5	8. Use: <input type="checkbox"/> Domestic <input type="checkbox"/> Public supply <input type="checkbox"/> Industry <input type="checkbox"/> Irrigation <input type="checkbox"/> Air conditioning <input checked="" type="checkbox"/> Stock <input type="checkbox"/> Lawn <input type="checkbox"/> Oil field water <input type="checkbox"/> Other		
white clay		6	10	9. Casing: Material <input type="checkbox"/> Height: 24 in. Threaded <input type="checkbox"/> Welded <input type="checkbox"/> Surface <input type="checkbox"/> in. RMP <input type="checkbox"/> PVC <input checked="" type="checkbox"/> Weight 200 lbs./ft. Dia. 5 in. to 234 ft. depth Wall Thickness: inches or Dia. <input type="checkbox"/> in. to <input type="checkbox"/> ft. depth Page No. 2001b		
hard clay		11	20	10. Screen: Manufacturer's name Jet Stream Type PVC Dia. 5" Slot/gauze 1/4" Length 140' Set between 94 ft. and 234 ft. <input type="checkbox"/> ft. and <input type="checkbox"/> ft. Gravel pack? <input checked="" type="checkbox"/> Size range of material 1/4-1/2		
sand + white clay		21	50	11. Static water level: <input type="checkbox"/> mo./day/yr. 120 ft. below land surface Date 4-23-79		
1" sand		51	105	12. Pumping level below land surfaces: 120 ft. after 12 hrs. pumping 30 g.p.m. <input type="checkbox"/> ft. after <input type="checkbox"/> hrs. pumping <input type="checkbox"/> g.p.m. Estimated maximum yield 30 g.p.m.		
clay + gravel		106	130	13. Water sample submitted: <input type="checkbox"/> mo./day/yr. <input type="checkbox"/> Yes <input checked="" type="checkbox"/> No Date <input type="checkbox"/>		
red clay		131	210	14. Well head completion: <input type="checkbox"/> Pitless adapter <input type="checkbox"/> Inches above grade		
red clay + sand		210	234	15. Well grouted? <input checked="" type="checkbox"/> With: <input type="checkbox"/> Neat cement <input type="checkbox"/> Bentonite <input checked="" type="checkbox"/> Concrete Depth: From 0 ft. to 12 ft.		
				16. Nearest source of possible contamination: ft. 400 Direction West Type Dam Well disinfected upon completion? <input type="checkbox"/> Yes <input checked="" type="checkbox"/> No		
				17. Pump: see 19 <input type="checkbox"/> Not installed Manufacturer's name <input type="checkbox"/> Model number <input type="checkbox"/> HP <input type="checkbox"/> Volts <input type="checkbox"/> Length of drop pipe <input type="checkbox"/> ft. capacity <input type="checkbox"/> g.p.m. Type: <input type="checkbox"/> Submersible <input type="checkbox"/> Turbine <input type="checkbox"/> Jet <input type="checkbox"/> Reciprocating <input type="checkbox"/> Centrifugal <input type="checkbox"/> Other		
				20. Water well contractor's certification: This well was drilled under my jurisdiction and this report is true to the best of my knowledge and belief. Bartel Rely 101 Business name <input type="checkbox"/> License No. <input type="checkbox"/> Address Englewood Rte Signed Bartel Rely Date 4-27-79 Authorized representative		
18. Elevation: 2300 ft Topography: <input type="checkbox"/> Hill <input checked="" type="checkbox"/> Slope <input type="checkbox"/> Upland <input type="checkbox"/> Valley		19. Remarks: windmill well 1 7/8" cap liner 2300 12-27-79				

Forward the white, blue and pink copies to the Department of Health and Environment

Form WWC-5