

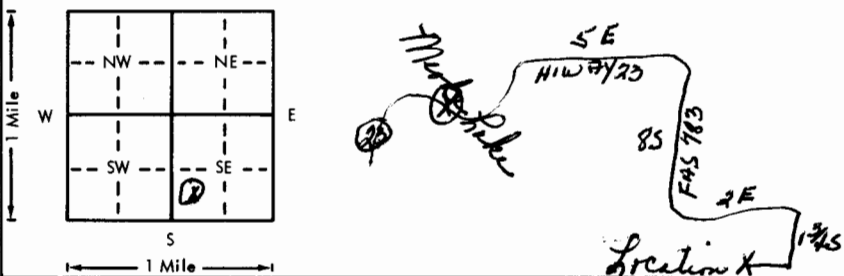
USE TYPEWRITER OR BALL
POINT PEN-PRESS FIRMLY,
PRINT CLEARLY.

WATER WELL RECORD
KSA 82a-1201-1215

Kansas Department of Health and
Environment-Division of Environment
(Water well Contractors)
Topeka, Kansas 66620

CWW Inv. # 12738

Thonoff #1

1. Location of well:		County Meade	Fraction 1/4 SW 1/4 SE 1/4	Section number 1	Township number T 35 S R 28 E/W	Range number
2. Distance and direction from nearest town or city: 5 east of Meade Lake 8 south, 2 east, 1 3/4 south, West of location.			3. Owner of well: Zenith Drilling Co., Rig #1 R.R. or street: Suite 600, 200 west Douglas City, state, zip code: Wichita, Kansas 67202			
4. Locate with "X" in section below:		Sketch map:		6. Bore hole dia. 8 in. Completion date 9-27 Well depth 240 ft.		
				7. Cable tool <input checked="" type="checkbox"/> Rotary <input type="checkbox"/> Driven <input type="checkbox"/> Dug <input type="checkbox"/> Hollow rod <input type="checkbox"/> Jetted <input type="checkbox"/> Bored <input type="checkbox"/> Reverse rotary		
5. Type and color of material		From	To	8. Use: <input type="checkbox"/> Domestic <input type="checkbox"/> Public supply <input type="checkbox"/> Industry <input type="checkbox"/> Irrigation <input type="checkbox"/> Air conditioning <input type="checkbox"/> Stock <input type="checkbox"/> Lawn <input checked="" type="checkbox"/> Oil field water <input type="checkbox"/> Other		
Surface		0	2	9. Casing: Material <input type="checkbox"/> Height: Above or below Threaded <input type="checkbox"/> Welded <input checked="" type="checkbox"/> Surface 28 in. RMP <input type="checkbox"/> PVC <input checked="" type="checkbox"/> Weight 2.78 lbs./ft. Dia. 5 in. to 135 ft. depth Wall Thickness: inches or Dia. 5 in. to 240 ft. depth gage No. 265		
Sandy clay		2	40	10. Screen: Manufacturer's name sawed perf. Type PVC Dia. 5" Slot/gauze .030 Length 100 Set between 135 ft. and 235 ft. ft. and ft. Gravel pack? yes Size range of material 1/8 - 3/16		
Fine sand & Med. to large sand		40	160	11. Static water level: 70 ft. below land surface Date 9-27-76 mo./day/yr.		
Medium to large sand		160	220	12. Pumping level below land surfaces: ft. after hrs. pumping g.p.m. ft. after hrs. pumping g.p.m. Estimated maximum yield 60 g.p.m.		
Med. to large sand & Redbed 40-60		220	240	13. Water sample submitted: Yes <input checked="" type="checkbox"/> No <input type="checkbox"/> Date		
				14. Well head completion: 28 inches above grade Pitless adapter		
				15. Well grouted? yes With: <input checked="" type="checkbox"/> Neat cement <input type="checkbox"/> Bentonite <input type="checkbox"/> Concrete Depth: From 0 ft. to 10 ft.		
				16. Nearest source of possible contamination: ft. 100 Direction NE Type oil well Well disinfected upon completion? <input checked="" type="checkbox"/> Yes <input type="checkbox"/> No		
				17. Pump: <input checked="" type="checkbox"/> Not installed Manufacturer's name Model number HP Volts Length of drop pipe ft. capacity g.p.m. Type: <input type="checkbox"/> Submersible <input type="checkbox"/> Turbine <input type="checkbox"/> Jet <input type="checkbox"/> Reciprocating <input type="checkbox"/> Centrifugal <input type="checkbox"/> Other		
18. Elevation:		19. Remarks:		20. Water well contractor's certification: This well was drilled under my jurisdiction and this report is true to the best of my knowledge and belief. Carlile Water Well 118 Business name License No. Address Box 275, Liberal, Ks. Signed Edward E. Means Date 10-8 Authorized representative		

Forward the white, blue and pink copies to the Department of Health and Environment

Form WWC-5