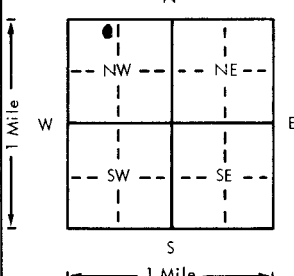
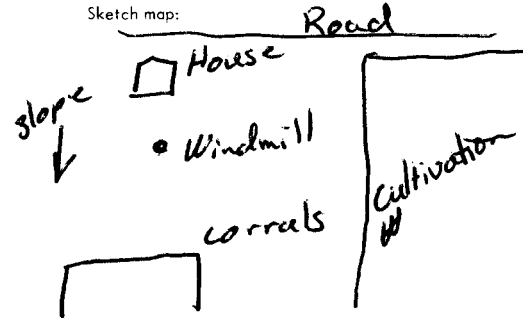


USE TYPEWRITER OR BALL
POINT PEN-PRESS FIRMLY,
PRINT CLEARLY.

WATER WELL RECORD
KSA 82a-1201-1215

Kansas Department of Health and
Environment-Division of Environment
(Water well Contractors)
Topeka, Kansas 66620

1. Location of well:		County <u>Meade</u>	Fraction <u>N 1/4 NW 1/4 NE 1/4</u>	Section number <u>5</u>	Township number T <u>35</u> S R <u>28</u> E <u>W</u>	Range number
2. Distance and direction from nearest town or city: <u>17 S, 2 3/4 W, 1/8 S of Meade</u>		3. Owner of well: <u>Omar LeValley</u>		R.R. or street: City, state, zip code: <u>Meade, Kansas 67864</u>		
4. Locate with "X" in section below:		Sketch map:		6. Bore hole dia. <u>8 1/2</u> in. Completion date <u>1-28-81</u> Well depth <u>100</u> ft.		
				7. <input checked="" type="checkbox"/> Cable tool <input checked="" type="checkbox"/> Rotary <input type="checkbox"/> Driven <input type="checkbox"/> Dug <input type="checkbox"/> Hollow rod <input type="checkbox"/> Jetted <input type="checkbox"/> Bored <input type="checkbox"/> Reverse rotary		
5. Type and color of material		From		To		8. Use: <input checked="" type="checkbox"/> Domestic <input type="checkbox"/> Public supply <input type="checkbox"/> Industry <input type="checkbox"/> Irrigation <input type="checkbox"/> Air conditioning <input type="checkbox"/> Stock <input type="checkbox"/> Lawn <input type="checkbox"/> Oil field water <input type="checkbox"/> Other
<u>Topsoil</u>		<u>0</u>		<u>2</u>		9. Casing: Material <u>PVC</u> Height: <u>24</u> in. Threaded <u>Welded</u> Surface <u>200</u> lbs./ft. RMP <u>PVC</u> <u>X</u> Weight <u>200</u> lbs./ft. Dia. <u>5</u> in. to <u>100</u> ft. depth Wall Thickness: inches or Dia. <u>5</u> in. to <u>100</u> ft. depth gage No. <u>40</u> inch
<u>light brown clay</u>		<u>2</u>		<u>18</u>		10. Screen: Manufacturer's name <u>Pumpco</u> Type <u>PVC</u> Dia. <u>5"</u> Slot/gauze <u>1/16"</u> Length <u>40'</u> Set between <u>60</u> ft. and <u>100</u> ft. ft. and <u>100</u> ft. Gravel pack? <u>Yes</u> Size range of material <u>5/16-1/8</u>
<u>light brown clay + fine sand</u>		<u>18</u>		<u>100</u>		11. Static water level: <u>30</u> ft. below land surface Date <u>1/28/81</u> mo./day/yr.
						12. Pumping level below land surfaces: <u>90</u> ft. after <u>1 1/2</u> hrs. pumping <u>10</u> g.p.m. ft. after <u>1</u> hrs. pumping <u>10</u> g.p.m. Estimated maximum yield <u>10</u> g.p.m.
						13. Water sample submitted: <u>Yes</u> <input checked="" type="checkbox"/> No <input type="checkbox"/> Date <u>1/28/81</u> mo./day/yr.
						14. Well head completion: <u>windmill</u> <u>Pitless adapter</u> <u>15</u> inches above grade
						15. Well grouted? <u>Yes</u> With: <u>Neat cement</u> <u>Bentonite</u> <input checked="" type="checkbox"/> Concrete Depth: From <u>0</u> ft. to <u>15</u> ft.
						16. Nearest source of possible contamination: ft. <u>150</u> Direction <u>S</u> Type <u>Cornfield</u> Well disinfected upon completion? <input checked="" type="checkbox"/> Yes <input type="checkbox"/> No
						17. Pump: <u>windmill</u> <input type="checkbox"/> Not installed Manufacturer's name <u>Windmill</u> Model number <u>10/A</u> HP <u>1</u> Volts <u>115</u> Length of drop pipe <u>100</u> ft. capacity <u>10</u> g.p.m. Type: <input type="checkbox"/> Submersible <input type="checkbox"/> Turbine <input type="checkbox"/> Jet <input checked="" type="checkbox"/> Reciprocating <input type="checkbox"/> Centrifugal <input type="checkbox"/> Other
						20. Water well contractor's certification: This well was drilled under my jurisdiction and this report is true to the best of my knowledge and belief. <u>Bartel</u> <u>10/A</u> Business name <u>Meade</u> License No. <u>10/A</u> Address <u>Meade</u> Signed <u>Bartel</u> Date <u>6-22-81</u> Authorized representative
18. Elevation:		19. Remarks:				
Topography: <input type="checkbox"/> Hill <input type="checkbox"/> Slope <input checked="" type="checkbox"/> Upland <input type="checkbox"/> Valley						

Forward the white, blue and pink copies to the Department of Health and Environment

Form WWC-5